


1/16 COR. ON N. LINE OF SE 1/4 SEC. 28

T31 R22

CONSTRUCTION TIES FOR 1/2" IRON
PIPE 1/16 COR.

9-19-79
H. LARSON
B. GUTZKO
D. KARLIK

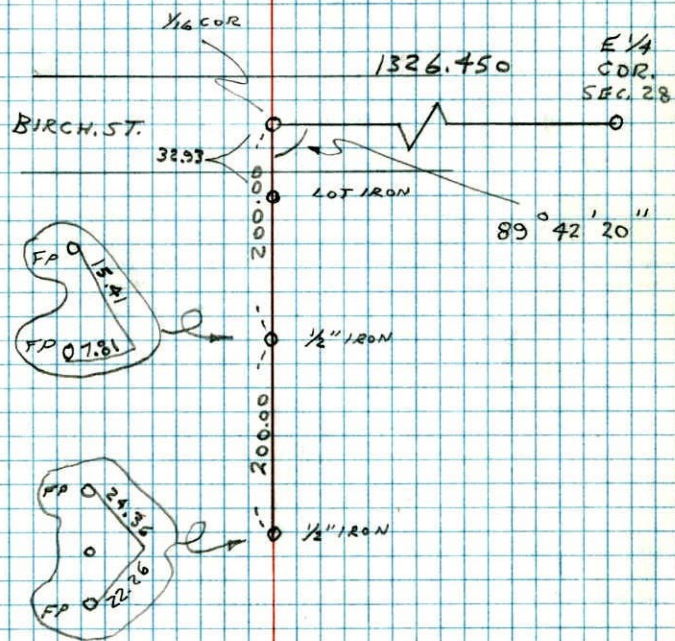

NO. 448

TELEPHONE