

CERTIFICATE OF LOCATION OF GOVERNMENT CORNER

County of Anoka

State of Minnesota


WITNESS Corner of Sec. 3 Township 31 Range 22
ON EAST LINE

I hereby certify that on the 9 day of JULY, 1993, I found the described corner which was evidenced by AREA RESURVEY


and I further certify that to perpetuate the location of said corner, I did, at the exact location thereof, place a permanent marker consisting of CAST IRON MONUMENT

which reference or witness monuments are located in the manner following:

N.A.D.	1983	Co-ordinates
County	Project	Co-ordinates
Northing	<u>160203.9573</u>	
Easting	<u>553036.6107</u>	
State Plane Co-ordinates		
Y	_____	
X	_____	
Date	_____	

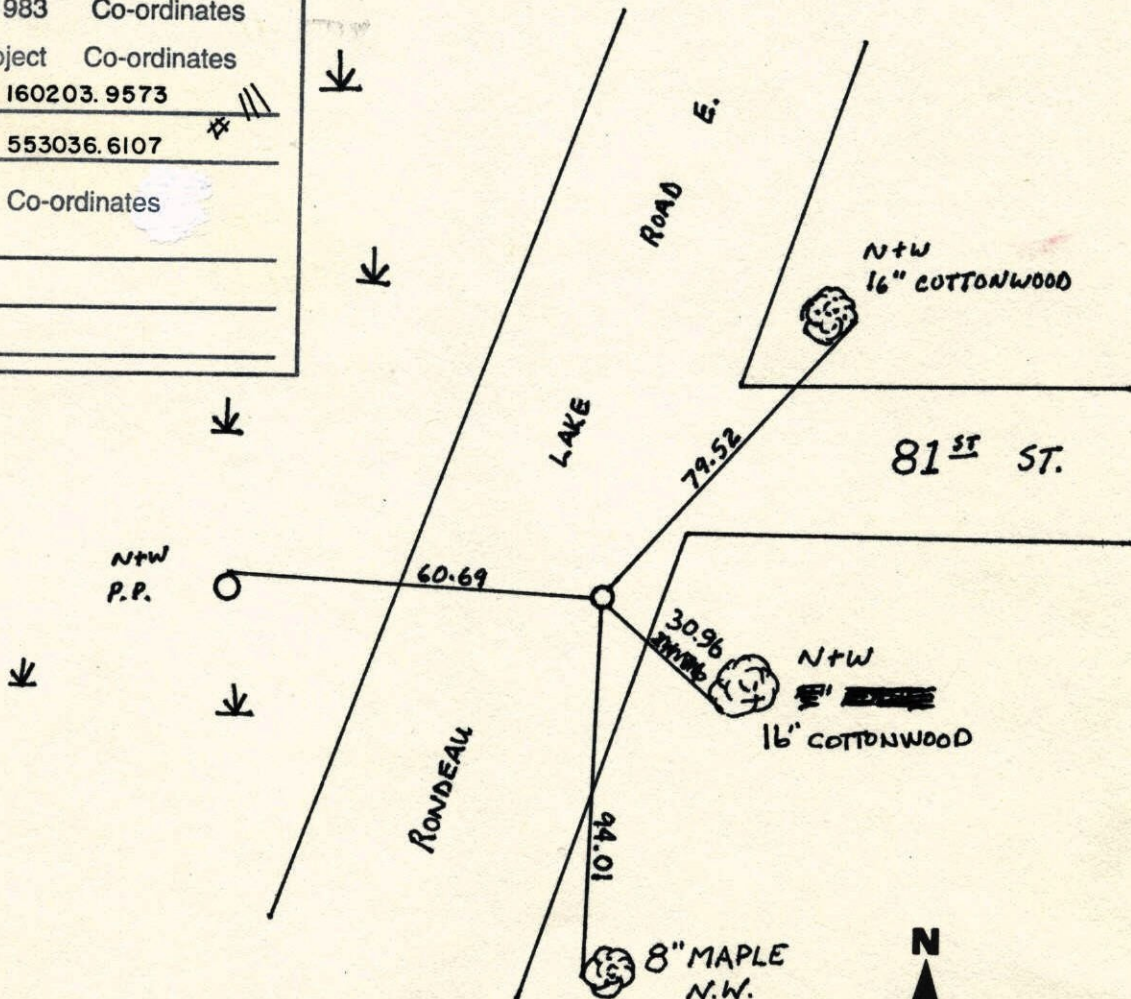


Revised date	Revised date	Revised date
<u>7-9-93</u>		
<u>6-12-96</u>		
<u>2-6-98</u>		

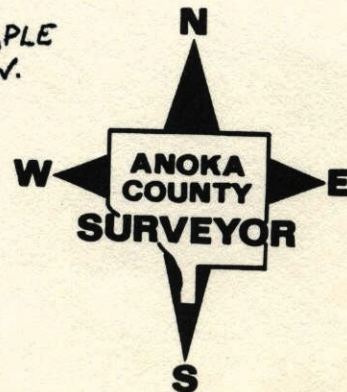

W.C. ON E. LINE: OF SEC. 3 T31 R22

SET CAST IRON MON. FROM AREA
RESURVEY C.I. FLUSH

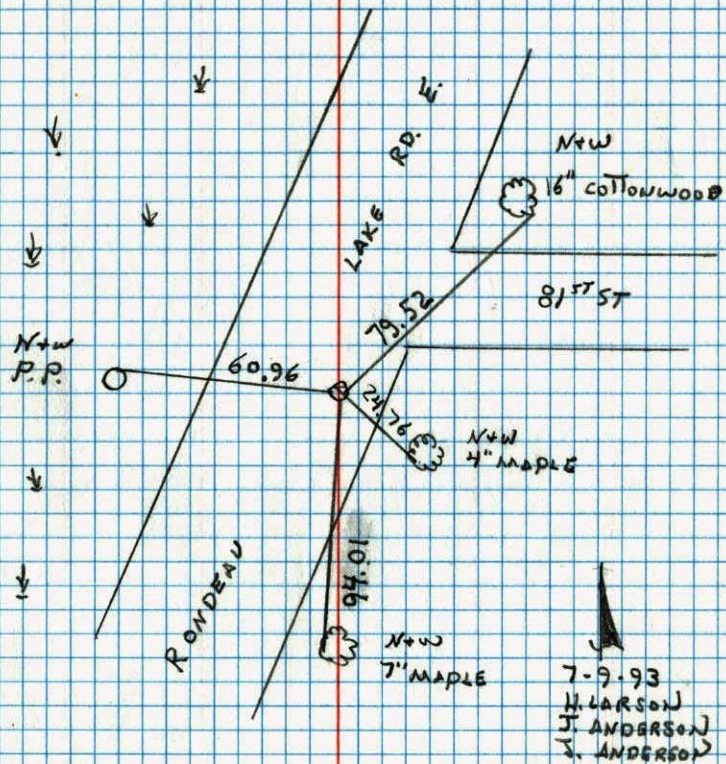

NO. 448

TELETYPE