

CERTIFICATE OF LOCATION OF GOVERNMENT CORNER

County of Anoka

State of Minnesota

Witness Corner of Sec. 15 Township 31 Range 22

On The North Line

I hereby certify that on the 25th day of March, 1964, I found the described corner which was

evidenced by area resurvey

3-29-11 JS SH. REMOVED R/W I.P. IN CONC + SET 10' TELSPAR w/ CAP + PUNCHMARK UP 1' SIGN + POST E. SIDE



and I further certify that to perpetuate the location of said corner, I did, at the exact location thereof, place a permanent marker consisting of a red and white iron pipe set in concrete

(WOBBLES) (UP 3')

JS SH
3-11-11
STATIC
R & W
I.P.

which reference or witness monuments are located in the manner following:

BK-SH
9/1/10
TAPED

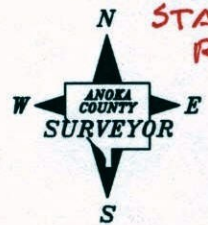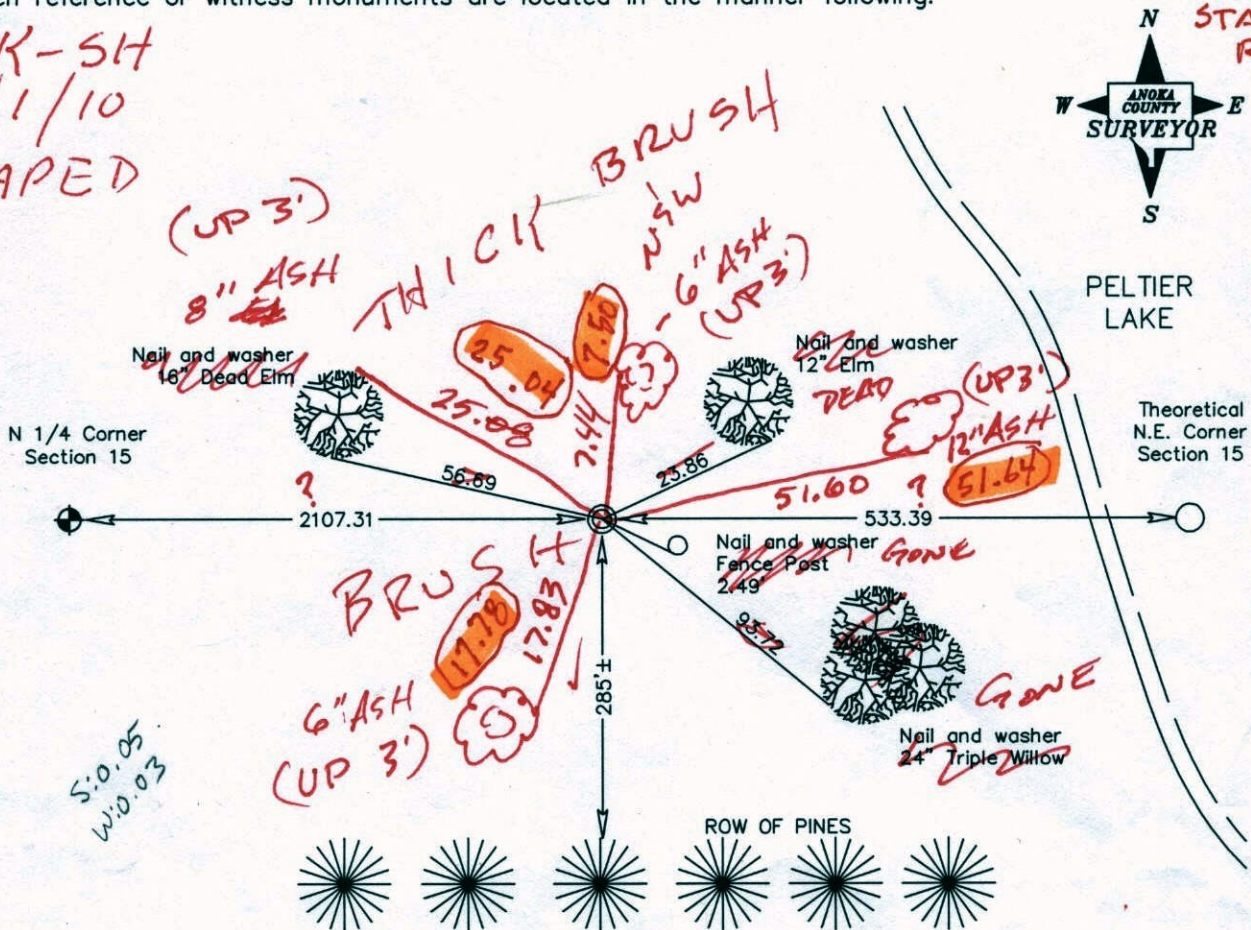

PELTIER LAKE

Theoretical N.E. Corner Section 15

ROW OF PINES

3/29/11

JS SH REPLACED R/W IN CONCRETE

Revised date

7/18/86
6/19/96
2/6/98

WITH TELSPAR AND ANOKA COUNTY ALUMINUM CAP WITH

PUNCH MARK (10' UP A FOOT)

NEW COORDS OF NEW POSITION

N.A.D. 1983 Co-ordinates

County Project Co-ordinates	State Plane Co-ordinates
Northing 153596.0415	Y _____
Easting 552428.9417	X _____

153596.00
552428.84

Date 2/6/98

3D QUALITY
0.10

CERTIFICATE OF LOCATION OF GOVERNMENT CORNER

County of Anoka


State of Minnesota

WITNESS Corner of Sec. 15 Township 31 Range 22
 NORTH LINE

I hereby certify that on the 25 day of MARCH, 1964, I found the described corner which was evidenced by AREA RESURVEY

and I further certify that to perpetuate the location of said corner, I did, at the exact location thereof, place a permanent marker consisting of RED AND WHITE IRON PIPE SET IN CONCRETE

which reference or witness monuments are located in the manner following:

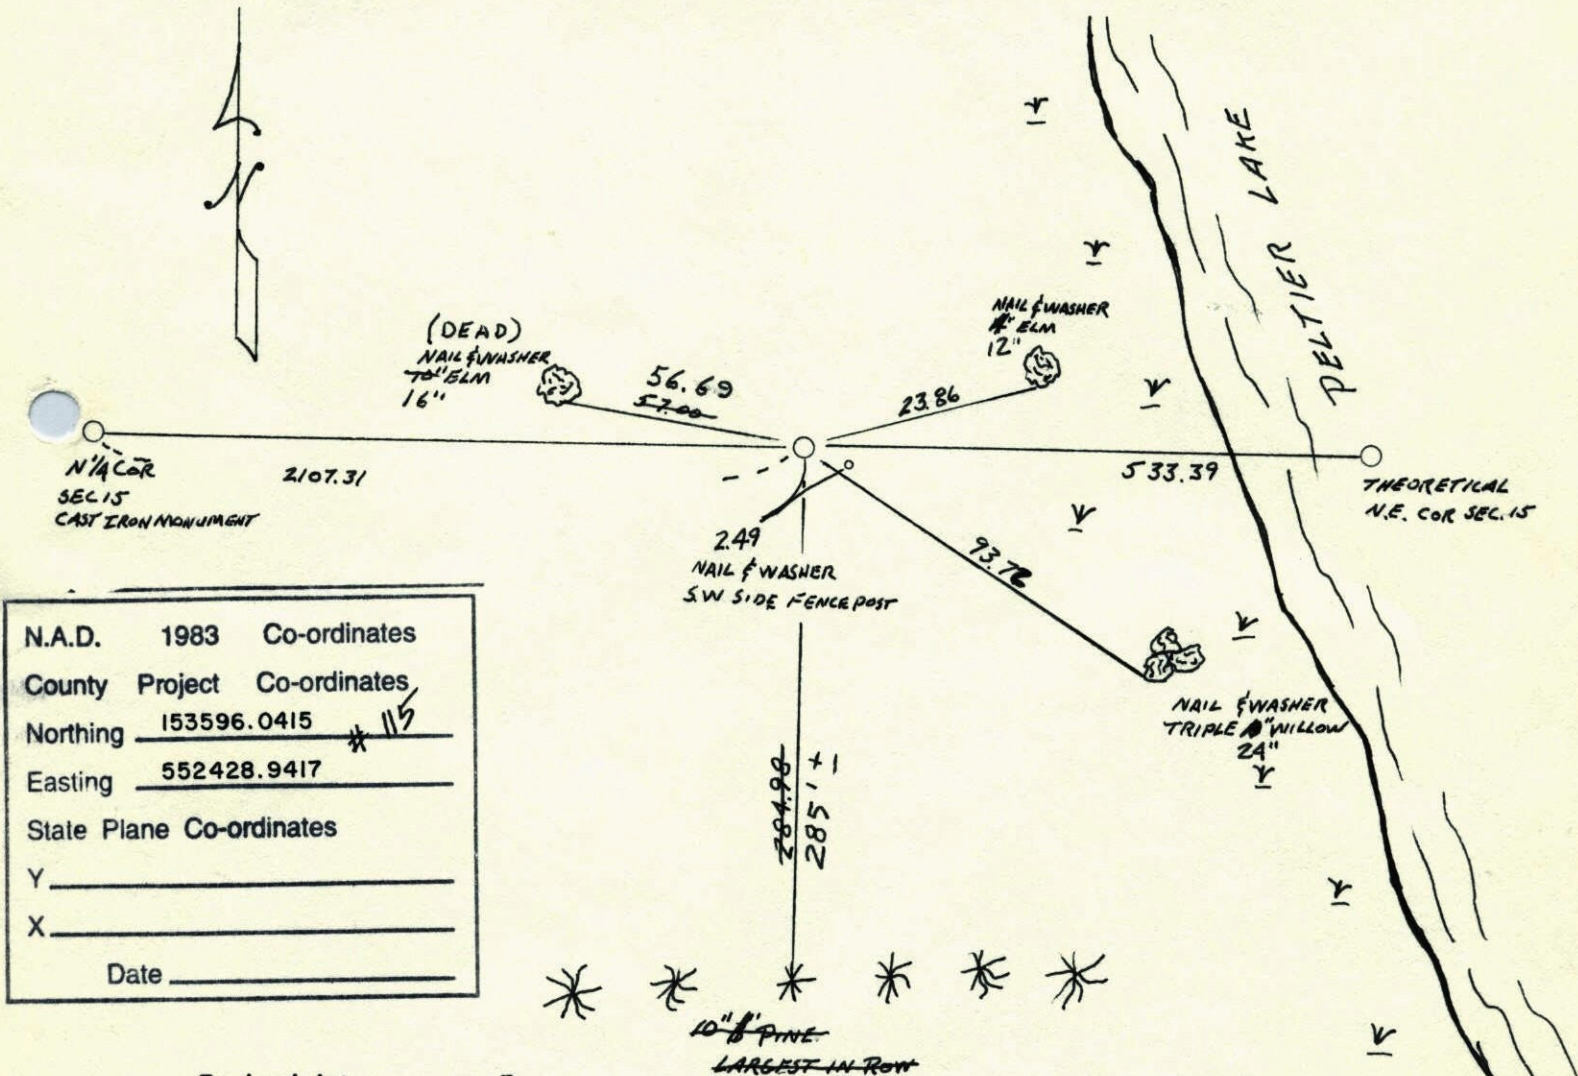

N.A.D.	1983	Co-ordinates
County	Project	Co-ordinates
Northing	<u>153596.0415</u>	* <u>119</u>
Easting	<u>552428.9417</u>	
State Plane Co-ordinates		
Y	_____	
X	_____	
Date	_____	

Revised date	By
<u>7-18-86</u>	<u>D. ROSS</u>
<u>6-19-96</u>	
<u>2-6-98</u>	

Minnesota State Plane Coordinates
 South Zone
 Y _____ X _____

 County Surveyor _____ Date _____
 Registered Land Surveyor No. _____

Witness Corner

48

on north line of Sec. 15-31-22

Set from Re-survey


Set R & W I.P. up 3.5'

30 July 64

March 25, 1964

Oliver-higard-Dunlop

J. Oliver
M.D. Anderson
E. Madson

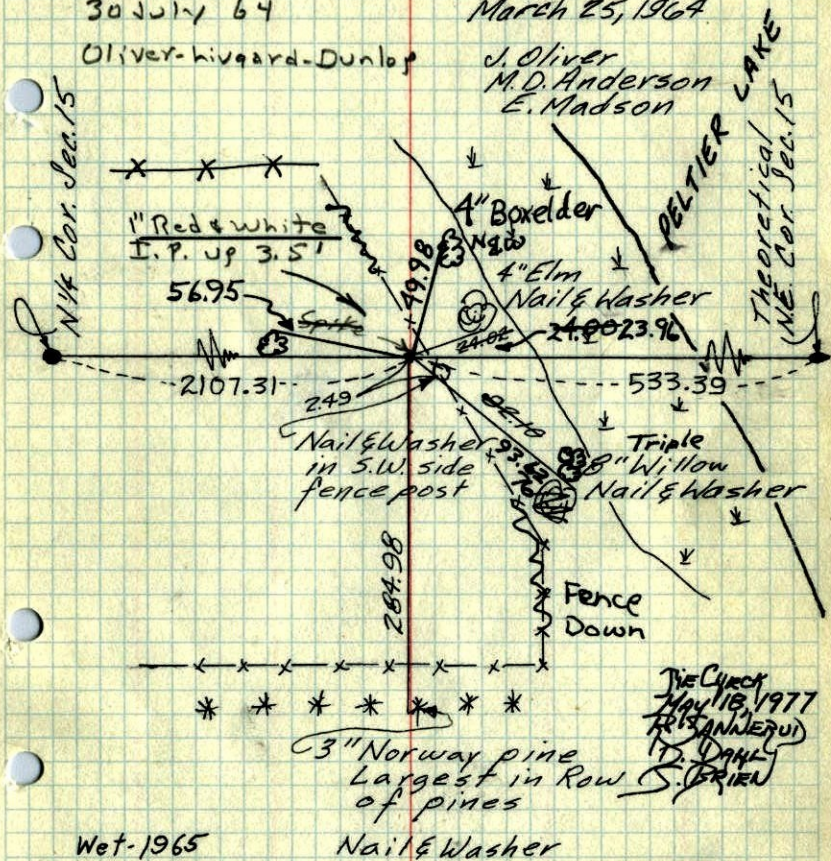

3" Norway pine
Largest in Row
of pines

Wet-1965

Tie Check


ROLAND W. ANDERSON
COUNTY SURVEYOR
ANOKA COUNTY, MINNESOTA
TEMPERATURE CORRECTED
AND HORIZONTALLY
TAPED MEASUREMENTS

1964

W.C. on North Line Sec. 15, T 31, R 22

Spk. set from Resurvey.

25 Mar. 64
20° #2
J. Oliver
M.D. Anderson
E. Madson

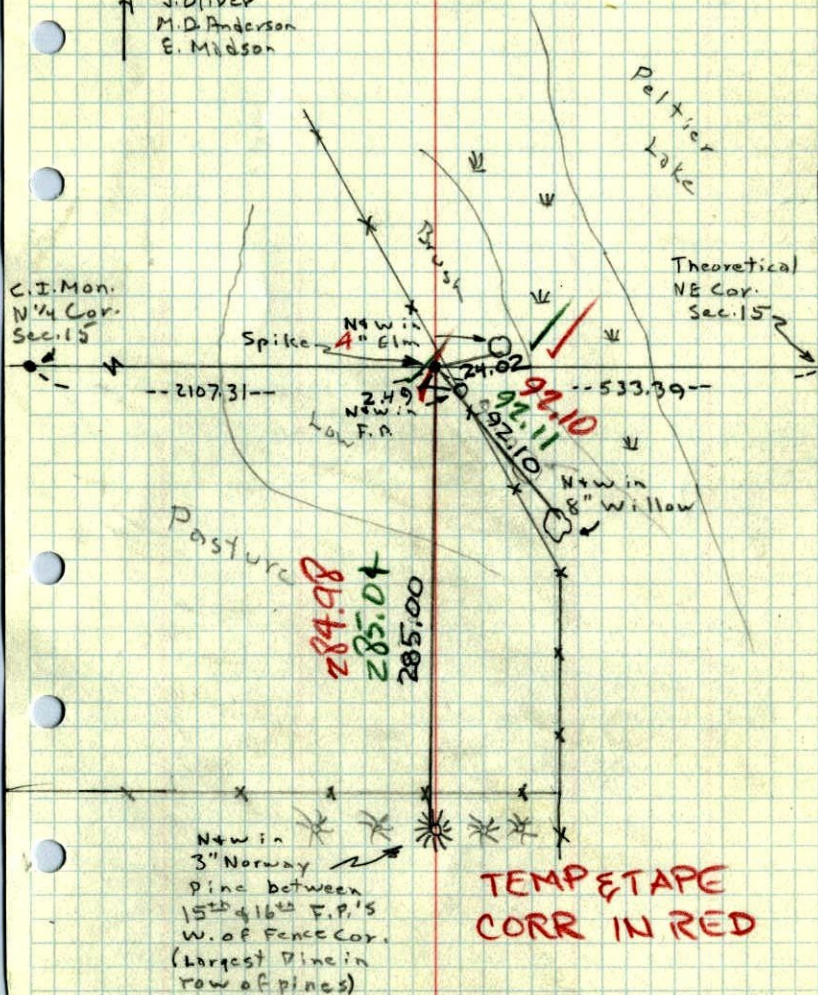

N 1/4 in
3" Norway
Pine between
15th & 16th F.P.'s
W. of Fence Cor.
(Largest Pine in
row of pines)

TEMP & TAPE
CORR IN RED