


Possible $\frac{1}{16}$ th

92A

$\frac{1}{16}$ th Cor. on N. line of NE $\frac{1}{4}$ Sec. 25-T31-R22

Found by Anoka County Highway Department.

Found $\frac{1}{2}$ " Iron Pipe up 3" with tape band marked 1979. (pulled for road cut).

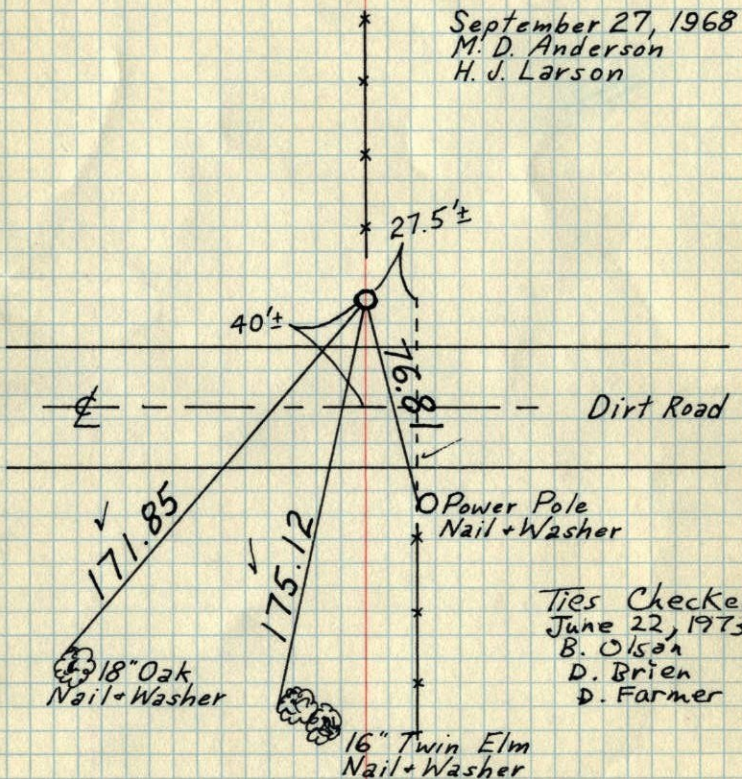

COULD NOT FIND
May 25, 1977
Fr. G. Walker

TEMPERATURE CORRECTED
AND HORIZONTALLY
TAPED MEASUREMENTS

Possible $\frac{1}{16}$ th

1968

$\frac{1}{16}$ th Cor. on N. line NE $\frac{1}{4}$ Sec. 25-T31-R22

found by A.C. Hay Dept.

found $\frac{1}{2}$ " I.P. up 3" with tape band marked 1979 (pulled for road cut)

Sept. 27, 1968

M. D. Anderson
H. J. Larson

Temp. 60 $^{\circ}$ ✓
Tape #5 ✓

