

# CERTIFICATE OF LOCATION OF GOVERNMENT CORNER

County of Anoka

State of Minnesota



## North 1/4 Corner of Sec. 1 Township 31 Range 22

On the 10th day of July, 1974, the described corner was evidenced by area resurvey

and to perpetuate the location of said corner, at the exact location thereof, a permanent marker was placed consisting of a red and white iron pipe

AND on the 28th day of December, 2010, said permanent marker was found broken off 0.2'± above the ice and the ties were updated

Updated reference ties are as shown below.

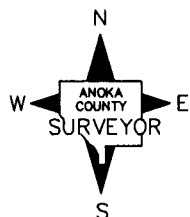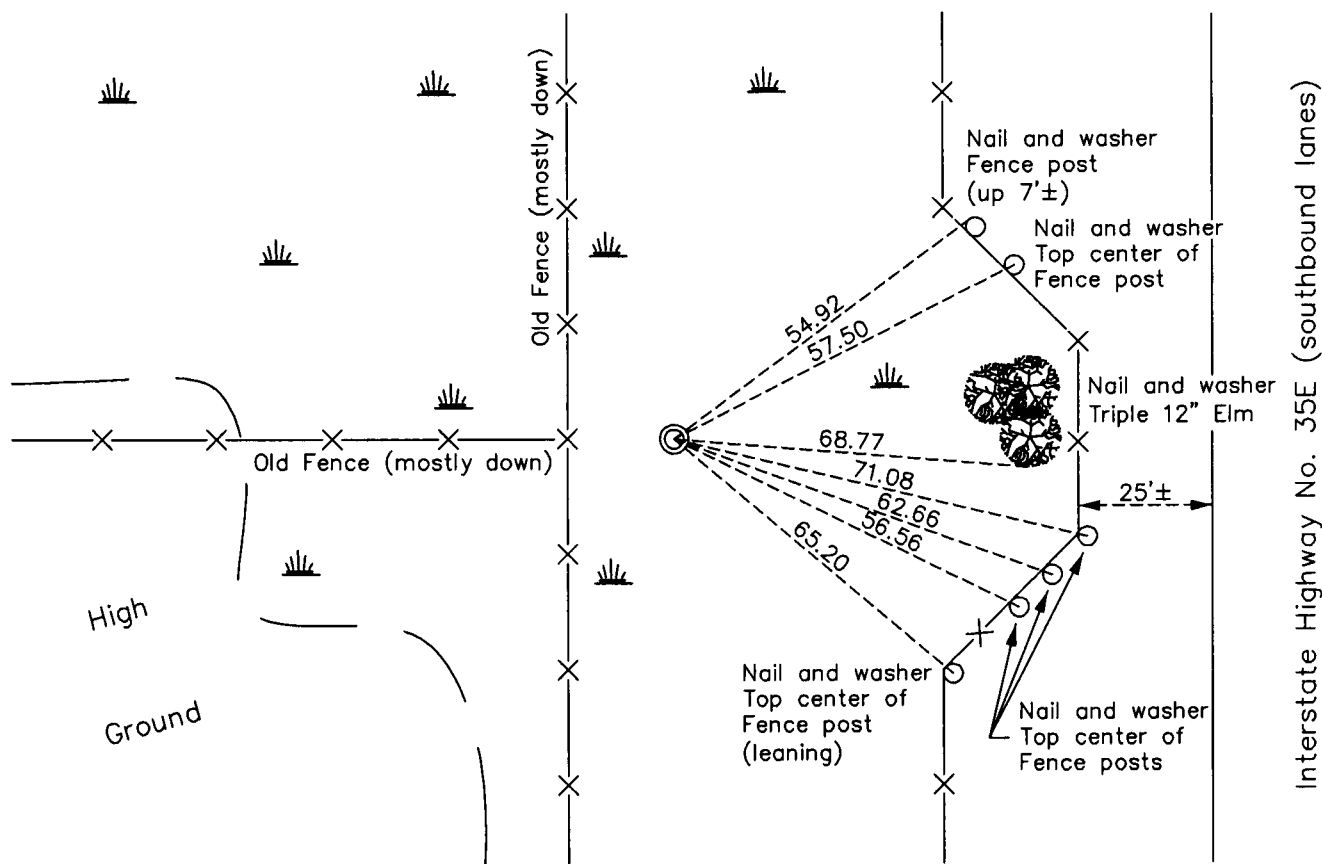

Revision Date

3/03/11

N.A.D. 1983 Coordinates  
(1996 Adjustment)

County Project Coordinates

Northing 164121.2685

Easting 561017.6799

Date 2/25/98

I hereby certify that this United States public land survey monument record is correct and complete to the best of my knowledge and belief.

*Larry D. Hoium* Date 3/03/11

Larry D. Hoium, Anoka County Surveyor

Minnesota License Number 18165