

CERTIFICATE OF LOCATION OF GOVERNMENT CORNER

County of Anoka

State of Minnesota



West 1/4 Corner of Sec. 10 Township 31 Range 22

On the 25th day of February, 1964, the described corner was evidenced by a 3/4" axle shaft from the plat of "Lake View Woodlands"

and to perpetuate the location of said corner, at the exact location thereof, a permanent marker was placed consisting of a red and white iron pipe

AND on the 27th day of January, 2017, said permanent marker was a red and white 2" square steel Telespar monument up 4'± with a sign attached and the ties were updated

Updated reference ties are as shown below.

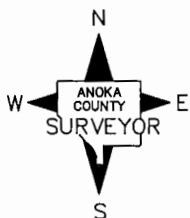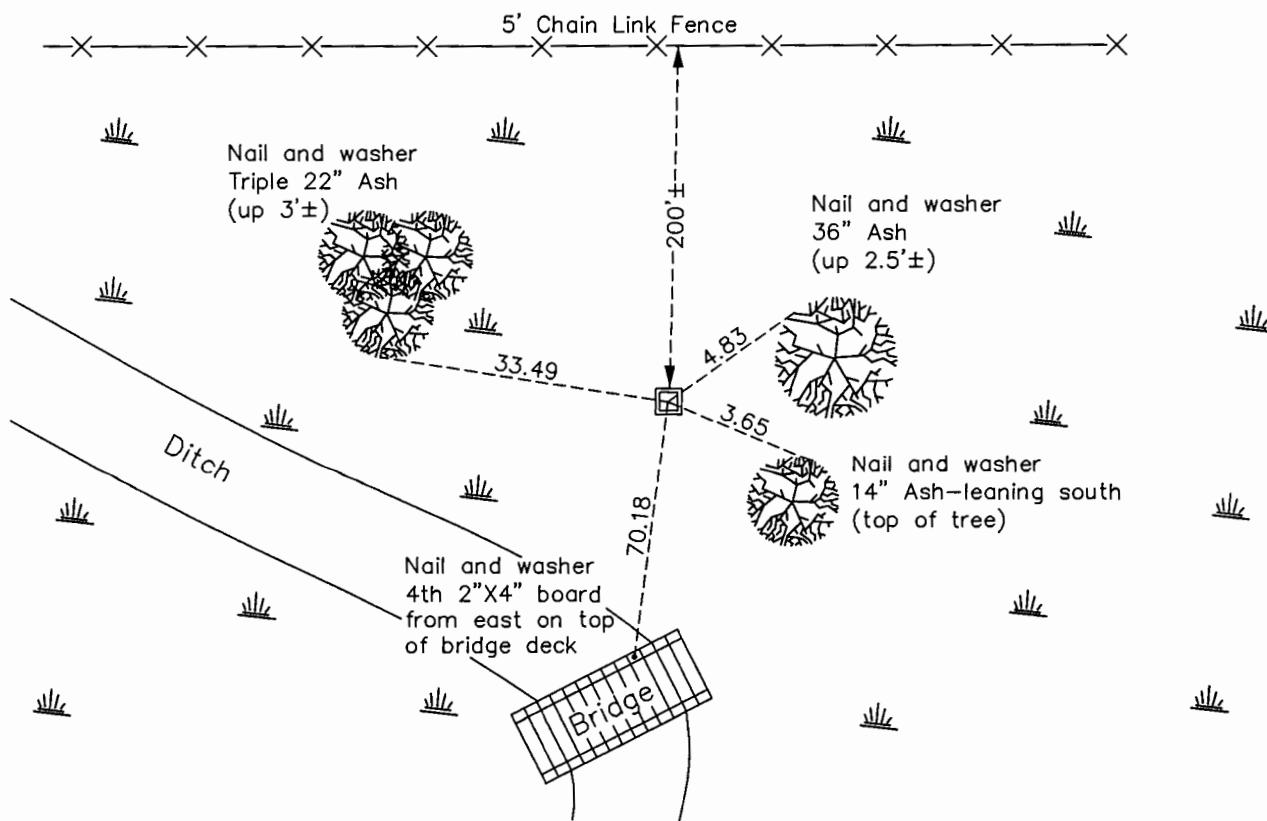

Revision Date

5/2/17

N.A.D. 1983 Coordinates
(1996 Adjustment)

County Project Coordinates	
Northing	<u>156194.9530</u>
Easting	<u>547717.8876</u>
Date	<u>2/09/98</u>

I hereby certify that this United States public land survey monument record is correct and complete to the best of my knowledge and belief.

Larry D. Hoium Date 6/30/17

Larry D. Hoium, Anoka County Surveyor

Minnesota License Number 18165

HISTORY OF GOVERNMENT CORNER

Page No. 39

County of Anoka

State of Minnesota

West 1/4 Corner of Sec. 10 Township 31 Range 22

CORNER HISTORY:

February 25, 1964 - Found 3/4" Axle Shaft from the plat of "Lake View Woodlands". Replaced Axle shaft with 1"X10' Red and White Iron Pipe. Established ties to monument.

March 28, 1966 - Set sign and post.

August 15, 1969 - Could not find Red and White Iron Pipe.

January 15, 1974 - Found Red and White Iron Pipe up 1'± and leaning west with a sign and post up 8'±. Updated ties.

January 4, 1978 - Found Red and White Iron Pipe and updated ties.

August 21, 1979 - Reset Red and White Iron Pipe from plat of "Lake View Woodlands" up 3'± with sign. Updated ties.

June 8, 1980 - Found Red and White Iron Pipe and updated ties.

July 24, 1986 - Found Red and White Iron Pipe and updated ties.

December 6, 1996 - Found Red and White Iron Pipe and updated ties.

February 9, 1998 - Found Red and White Iron Pipe and established NAD 1983 (1996 Adjustment) Anoka County Project Coordinates by Static GPS methods. Updated ties.

August 18, 2010 - Found Red and White Iron Pipe up 3'± with a sign attached and updated ties.

January 27, 2017 - Found Red and White 2" square steel Telespar monument up 4'± with a sign attached and updated ties.