

CERTIFICATE OF LOCATION OF GOVERNMENT CORNER

County of Anoka


State of Minnesota

CENTER Corner of Sec. 15 Township 31 Range 22

I hereby certify that on the 15TH day of OCT, 19 75, I found the described corner which was evidenced by 1 1/2" IRON PIPE

and I further certify that to perpetuate the location of said corner, I did, at the exact location thereof, place a permanent marker consisting of RED + WHITE IRON PIPE

which reference or witness monuments are located in the manner following:

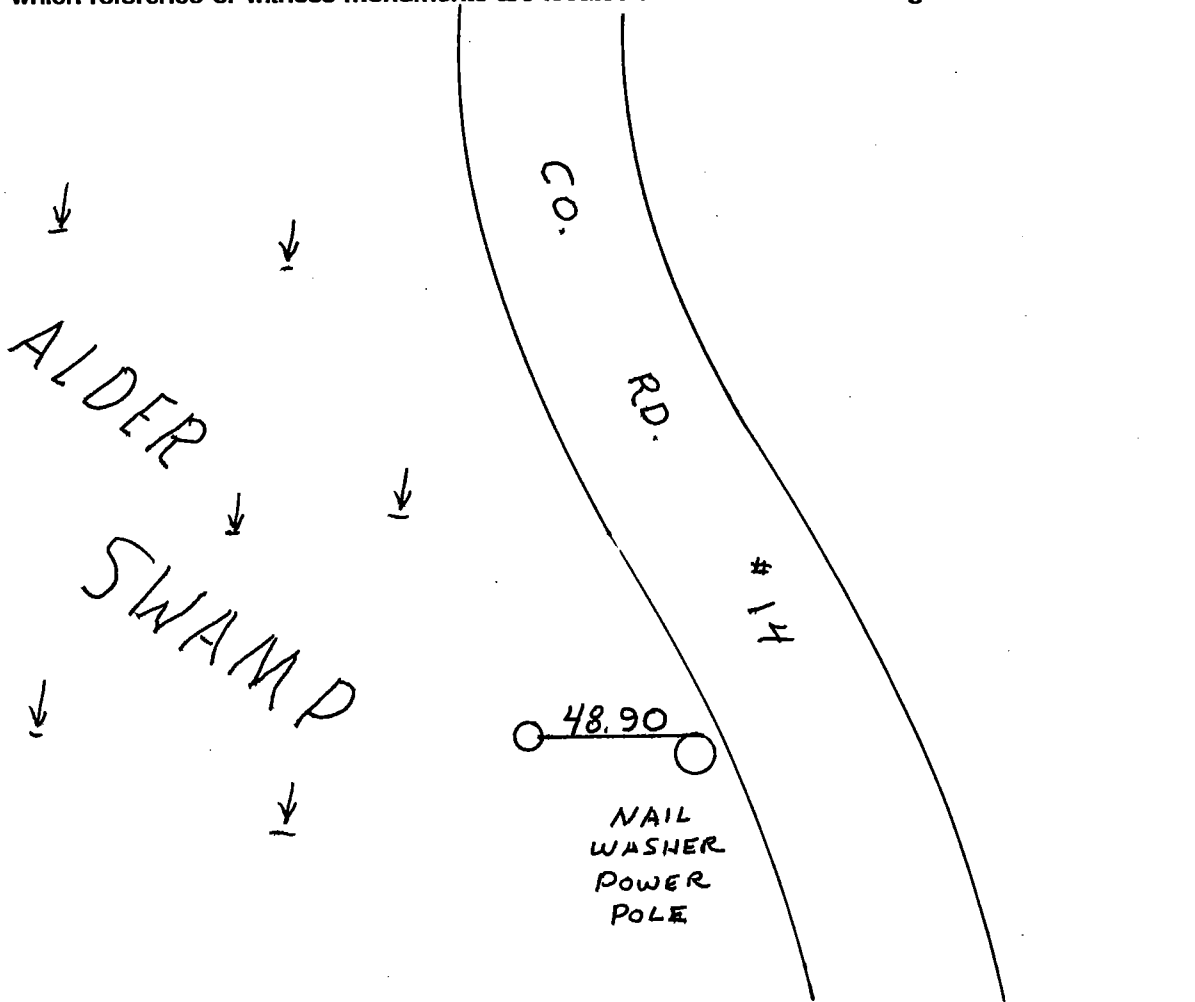

Revised date	Revised date	Revised date
10-15-75		
5-19-77		
8-1-80		
7-17-86		
6-28-91		
6-14-96		

