

CERTIFICATE OF LOCATION OF GOVERNMENT CORNER

County of Anoka


State of Minnesota

CENTER Corner of Sec. 14 Township 31 Range 22

I hereby certify that on the 9 day of JULY, 1965, I found the described corner which was evidenced by 1/2" IRON

and I further certify that to perpetuate the location of said corner, I did, at the exact location thereof, place a permanent marker consisting of ONE HALF INCH IRON PIPE

which reference or witness monuments are located in the manner following:

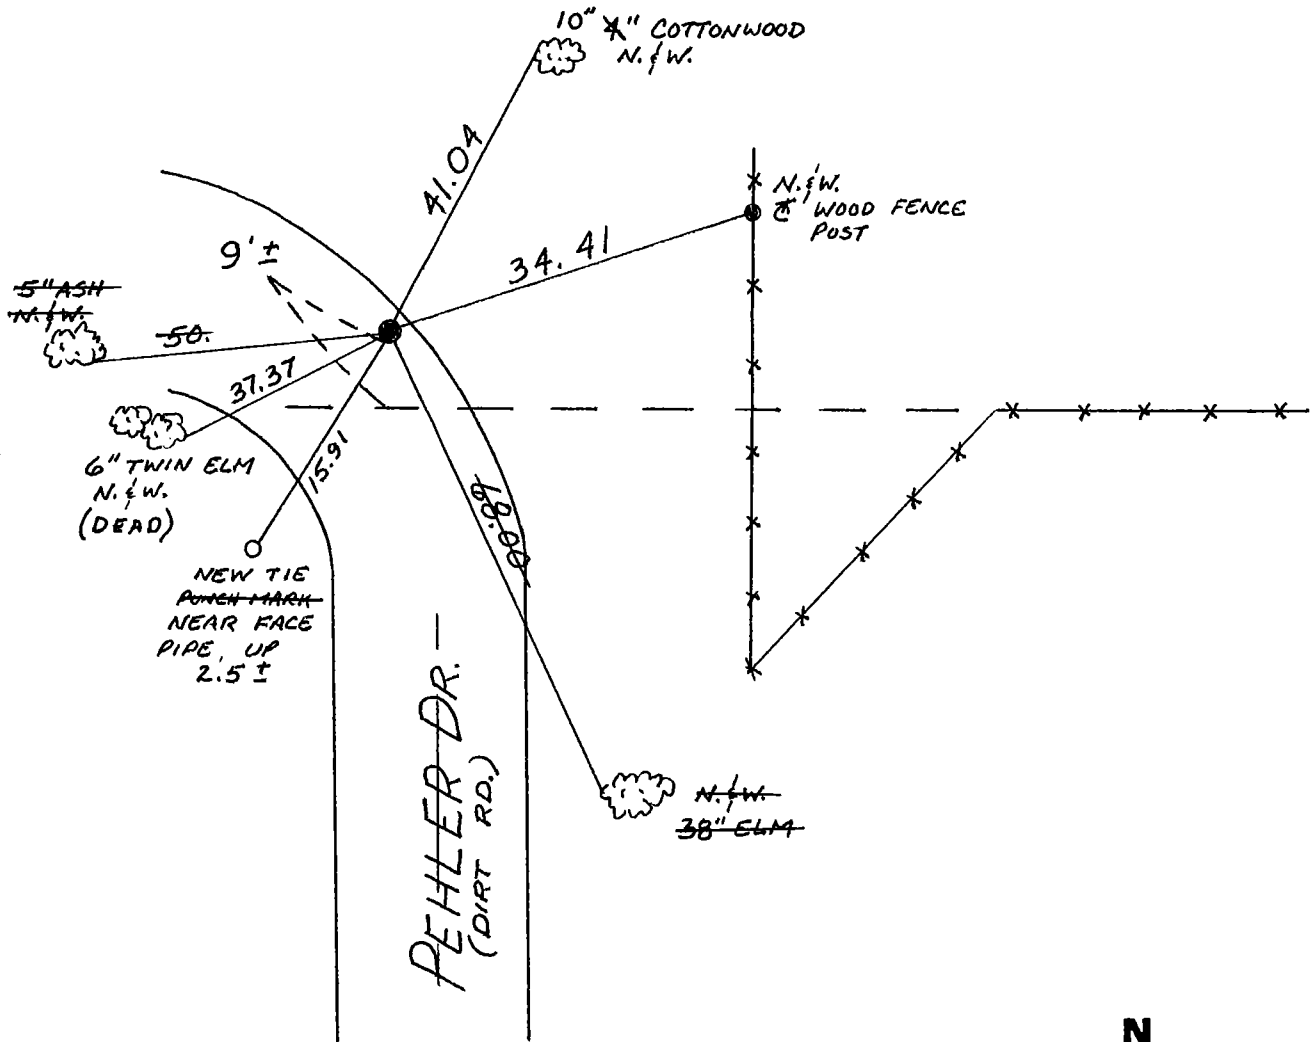

Revised date	Revised date	Revised date
11-5-90		
10-28-91	HL	

