

# CERTIFICATE OF LOCATION OF GOVERNMENT CORNER

County of Anoka

State of Minnesota



## North $\frac{1}{4}$ Corner of Sec. 36 Township 31 Range 22

On the 7th day of August, 1964, the described corner was evidenced by a 1" iron pipe

and to perpetuate the location of said corner, at the exact location thereof, a permanent marker was placed consisting of a red and white 2" square steel Telespar monument with a sign and post on the north side

AND on the 24th day of January, 2017, said permanent marker was found up 4'± and the ties were updated

Updated reference ties are as shown below.

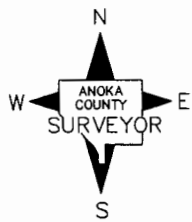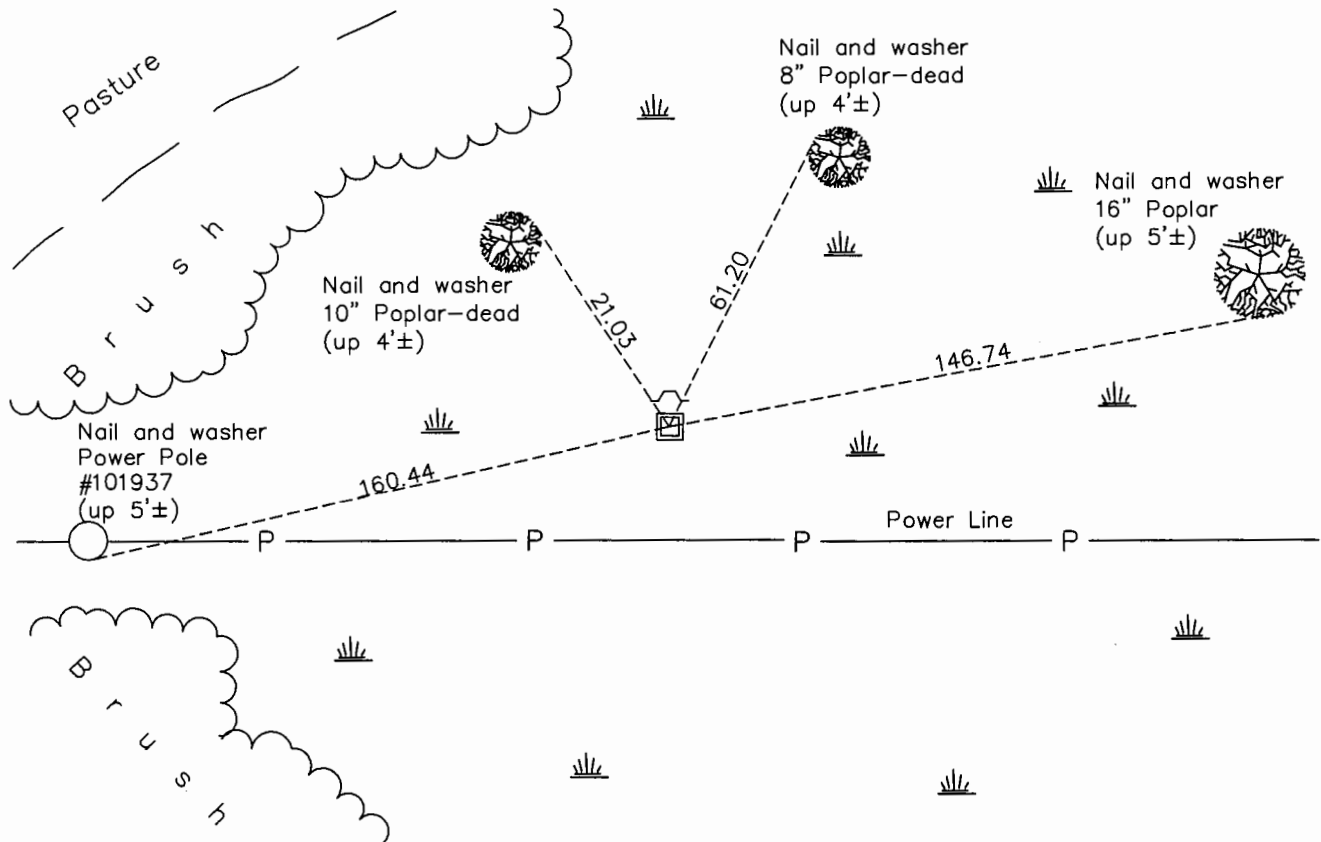

N.A.D. 1983 Coordinates  
(1996 Adjustment)

County Project Coordinates	
Northing	<u>137704.4350</u>
Easting	<u>560934.1185</u>
Date	<u>4/20/98</u>

Revision Date  
5/22/17

I hereby certify that this United States public land survey monument record is correct and complete to the best of my knowledge and belief.

*Larry D. Hoium* Date 8/30/17

Larry D. Hoium, Anoka County Surveyor

Minnesota License Number 18165

# HISTORY OF GOVERNMENT CORNER

Page No. 117

County of Anoka

State of Minnesota

## North 1/4 Corner of Sec. 36 Township 31 Range 22

### **CORNER HISTORY:**

August 5, 1946 - Cartwright found Concrete Monument. Established ties to monument.

August 7, 1964 - Found 1" Pinched Iron Pipe up 16"± with field stone on northeast side. Could not find concrete monument. Updated ties.

July 7, 1965 - Found Iron Pipe and updated ties.

July 16, 1973 - Found Iron Pipe and updated ties. Set sign and post 1'± north side of iron pipe.

June 2, 1977 - Found Iron Pipe and updated ties.

August 15, 1980 - Found Iron Pipe and updated ties.

June 7, 1983 - Found Iron Pipe leaning. Replaced pinched iron pipe with a Red and White Iron Pipe set up 3'± and updated ties.

December 18, 1984- Found Red and White Iron Pipe and updated ties.

July 30, 1992 - Found Red and White Iron Pipe with sign and post on the north side and updated ties.

June 27, 1996 - Found Iron Pipe and updated ties.

April 20, 1998 - Found Red and White Iron Pipe and established NAD 1983 (1996 Adjustment) Anoka County Project Coordinates by Static GPS methods. Updated ties.

October 6, 2010 - Found Red and White Iron Pipe up 4'± and updated ties.

January 24, 2017 - Found Red and White 2" square steel Telespar Monument up 4'± and updated ties.