

CERTIFICATE OF LOCATION OF GOVERNMENT CORNER

County of Anoka


State of Minnesota

CENTER Corner of Sec. 34 Township 31 Range 22

I hereby certify that on the 27 day of August, 1968, I found the described corner which was evidenced by R.M. Knudsen's ties

and I further certify that to perpetuate the location of said corner, I did, at the exact location thereof, place a permanent marker consisting of THREE QUARTER INCH IRON PIPE

which reference or witness monuments are located in the manner following:

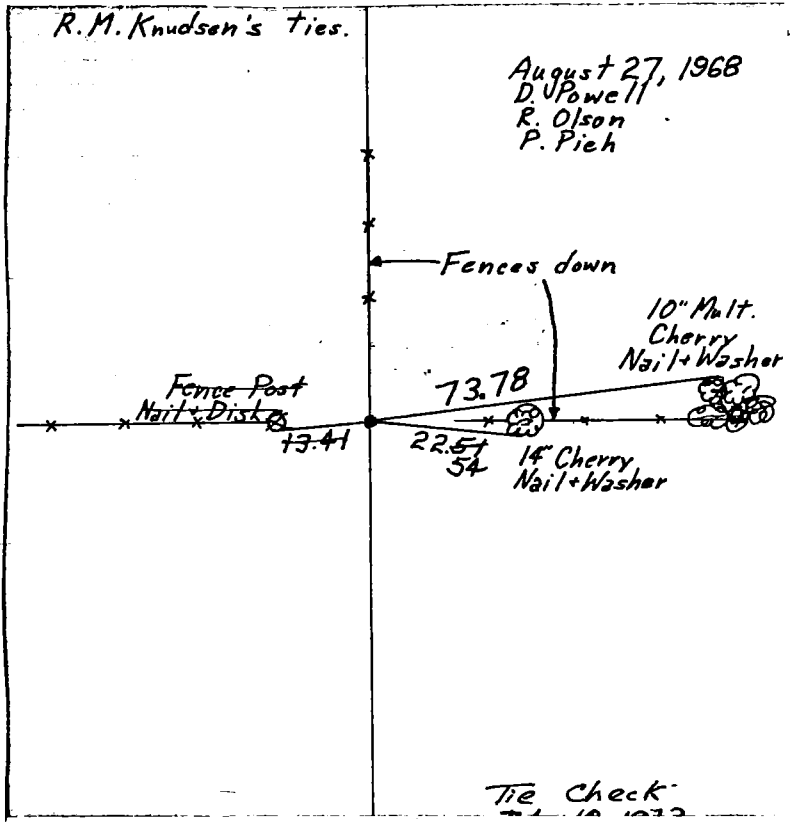

Revised date
6-13-77

By
R. Sannerud

Minnesota State Plane Coordinates
South Zone

Y _____ X _____

County Surveyor _____ Date _____

Registered Land Surveyor No. _____