

CERTIFICATE OF LOCATION OF GOVERNMENT CORNER

County of Anoka



State of Minnesota

Center Corner of Sec. 36 Township 31 Range 22

I hereby certify that on the ____ day of _____, ____, I found the described corner which was evidenced by _____ (FOR REFERENCE ONLY)

and I further certify that to perpetuate the location of said corner, I did, at the exact location thereof, place a permanent marker consisting of _____

which reference or witness monuments are located in the manner following:

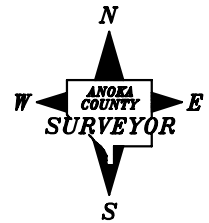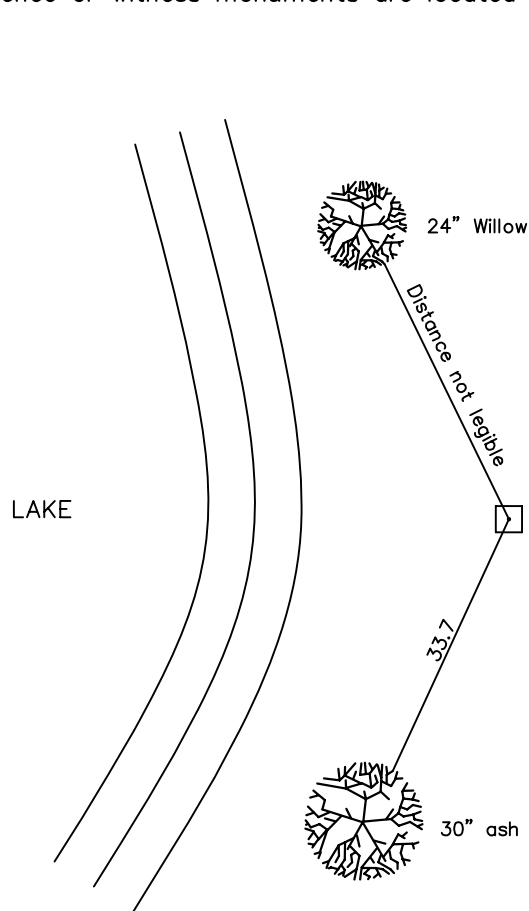

Revised date

N.A.D. 1983 Co-ordinates

County Project Co-ordinates	State Plane Co-ordinates
Northing _____	Y _____
Easting _____	X _____

Date _____