

CERTIFICATE OF LOCATION OF GOVERNMENT CORNER

County of Anoka

State of Minnesota



South 1/4 Corner of Sec. 36 Township 31 Range 22

On the 16th day of May, 1963, the described corner was evidenced by a 1" iron pipe

and to perpetuate the location of said corner, at the exact location thereof, a permanent marker was placed consisting of a cast iron monument

AND on the 19th day of July, 2010, said permanent marker was found and the ties were updated

Updated reference ties are as shown below.

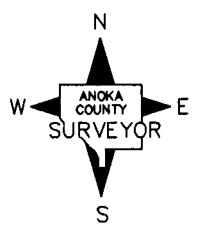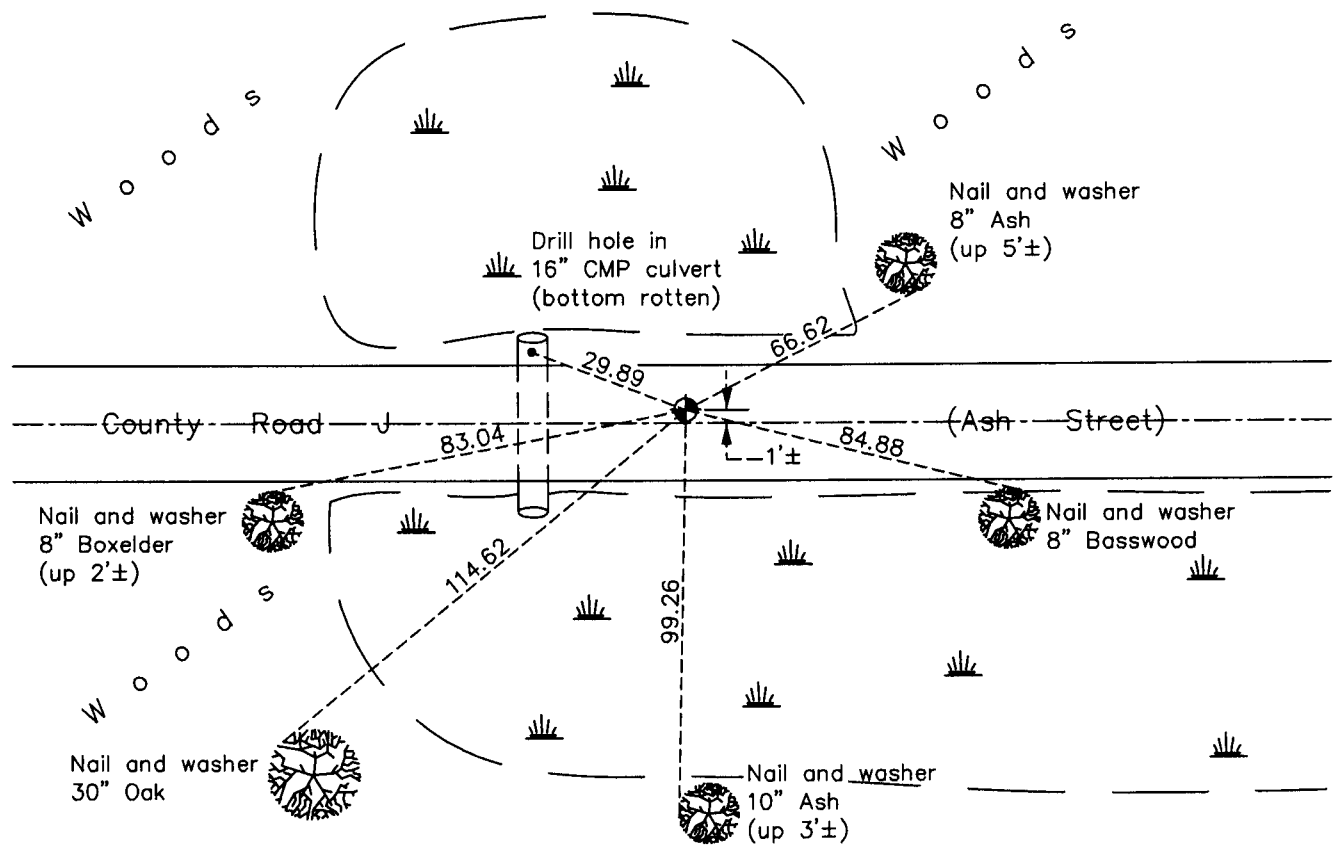

Revision Date
2/23/11

N.A.D. 1983 Coordinates
 (1996 Adjustment)

County Project Coordinates	
Northing	132394.5992
Easting	560936.6951
Date	4/06/98

I hereby certify that this United States public land survey monument record is correct and complete to the best of my knowledge and belief.

Larry D. Hoium Date 2/23/11

Larry D. Hoium, Anoka County Surveyor
 Minnesota License Number 18165