

CERTIFICATE OF LOCATION OF GOVERNMENT CORNER

County of Anoka

State of Minnesota

SOUTHWEST Corner of Sec. 6 Township 32 Range 25

I hereby certify that on the 20TH day of AUGUST, 19 68, I found the described corner which was evidenced by GRANITE MONUMENT

and I further certify that to perpetuate the location of said corner, I did, at the exact location thereof, place a permanent marker consisting of GRANITE MONUMENT ~~WITH SIGN AND POST~~
~~ON NORTH SIDE~~ (MONUMENT LOOSE, MAY NEED TO BE


which reference or witness monuments are located in the manner following:

RESET)

~~MONUMENT WAS LEAVING SOUTHEAST.~~
~~WE STOOD IT UP AND CHECKED TIES.~~
~~MONUMENT LOOSE.~~

N.A.D.	1983	Co-ordinates
County	Project	Co-ordinates
Easting		<u>436955.8772</u>
State Plane Co-ordinates		
Y	<u>NRS COORDS NEW R/W W/CAP</u>	
Date <u>1/25/00</u>		

3 D QUALITY
0.06

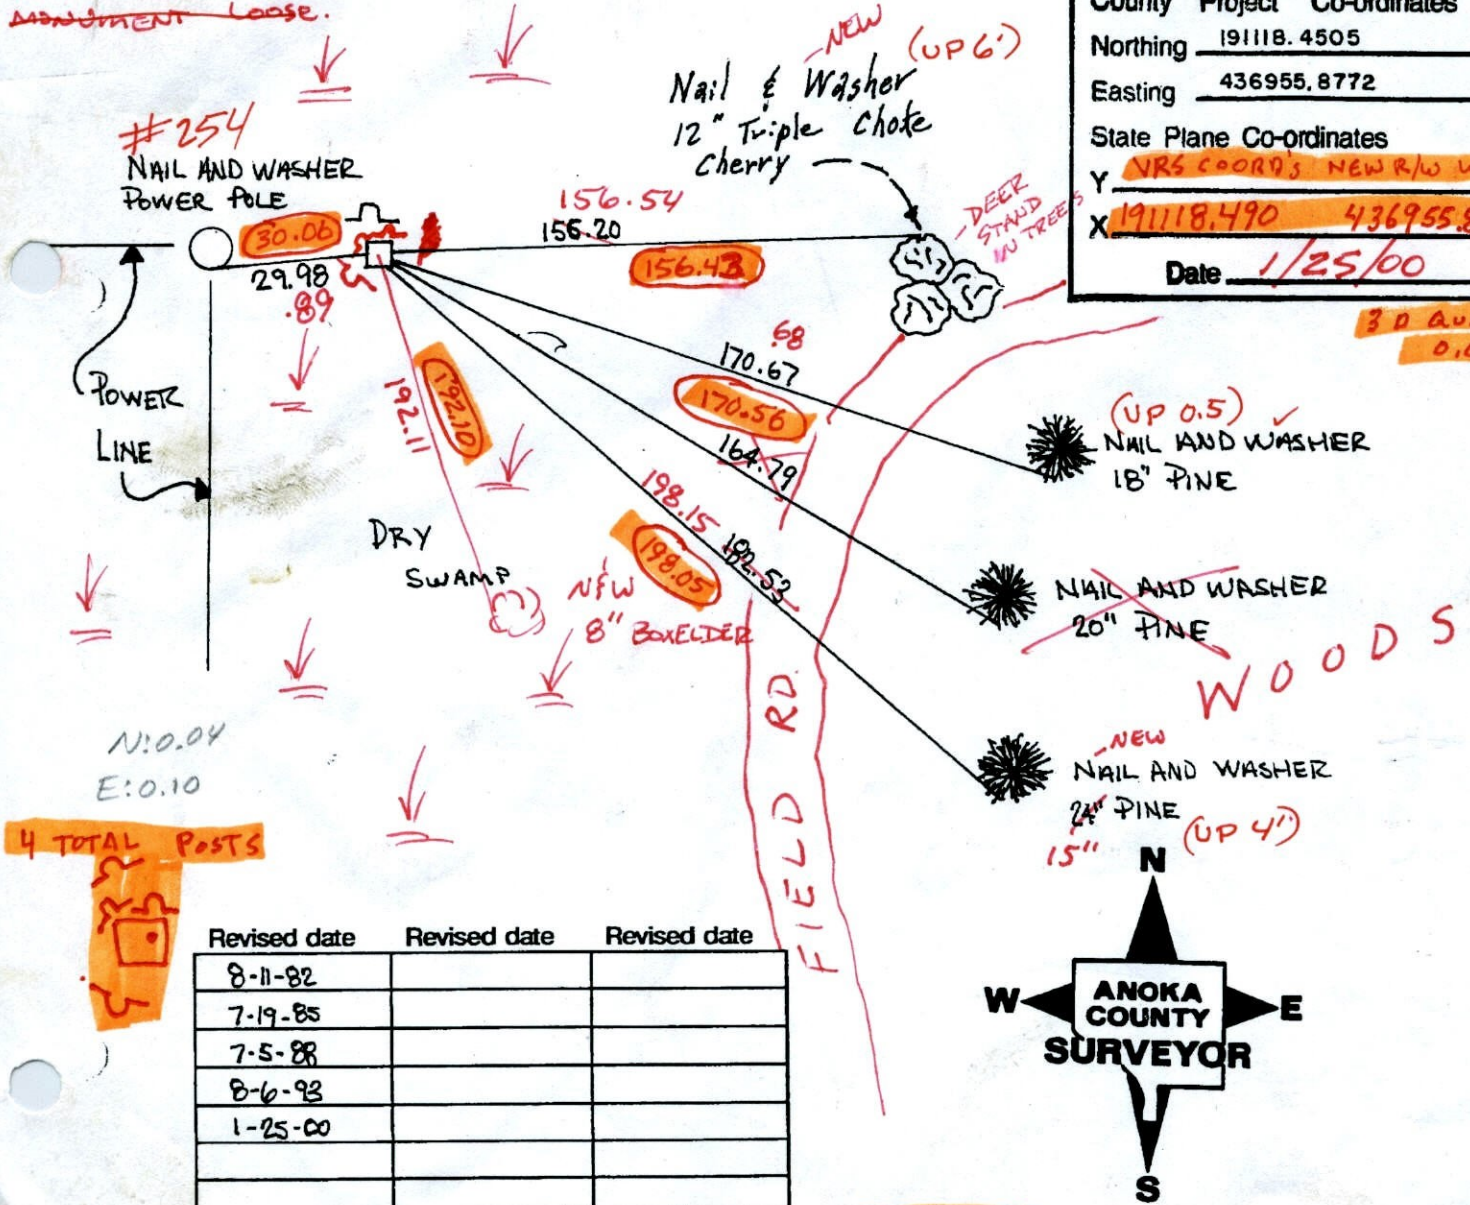

N: 0.04
E: 0.10
4 TOTAL POSTS

SH 16. 2-17-11 REMOVED GRANITE MON. + RESET R/W TELSPAR W/CAP + PUNCH MARK
R/W 1.5' UP (POSTS N SIDE + NW SIDE AGAINST R/W DOWN BELOW CAP)

CERTIFICATE OF LOCATION OF GOVERNMENT CORNER

County of Anoka

State of Minnesota


SOUTHWEST Corner of Sec. 6 Township 32 Range 25

I hereby certify that on the 20TH day of AUGUST, 19 68, I found the described corner which was evidenced by GRANITE MONUMENT


and I further certify that to perpetuate the location of said corner, I did, at the exact location thereof, place a permanent marker consisting of GRANITE MONUMENT WITH SIGN AND POST ON NORTH SIDE

which reference or witness monuments are located in the manner following:

N.A.D.	1983	Co-ordinates
County	Project	Co-ordinates
Northing	<u>191118.4505</u>	
Easting	<u>436955.8772</u>	
State Plane Co-ordinates		
Y	_____	
X	_____	
Date _____		

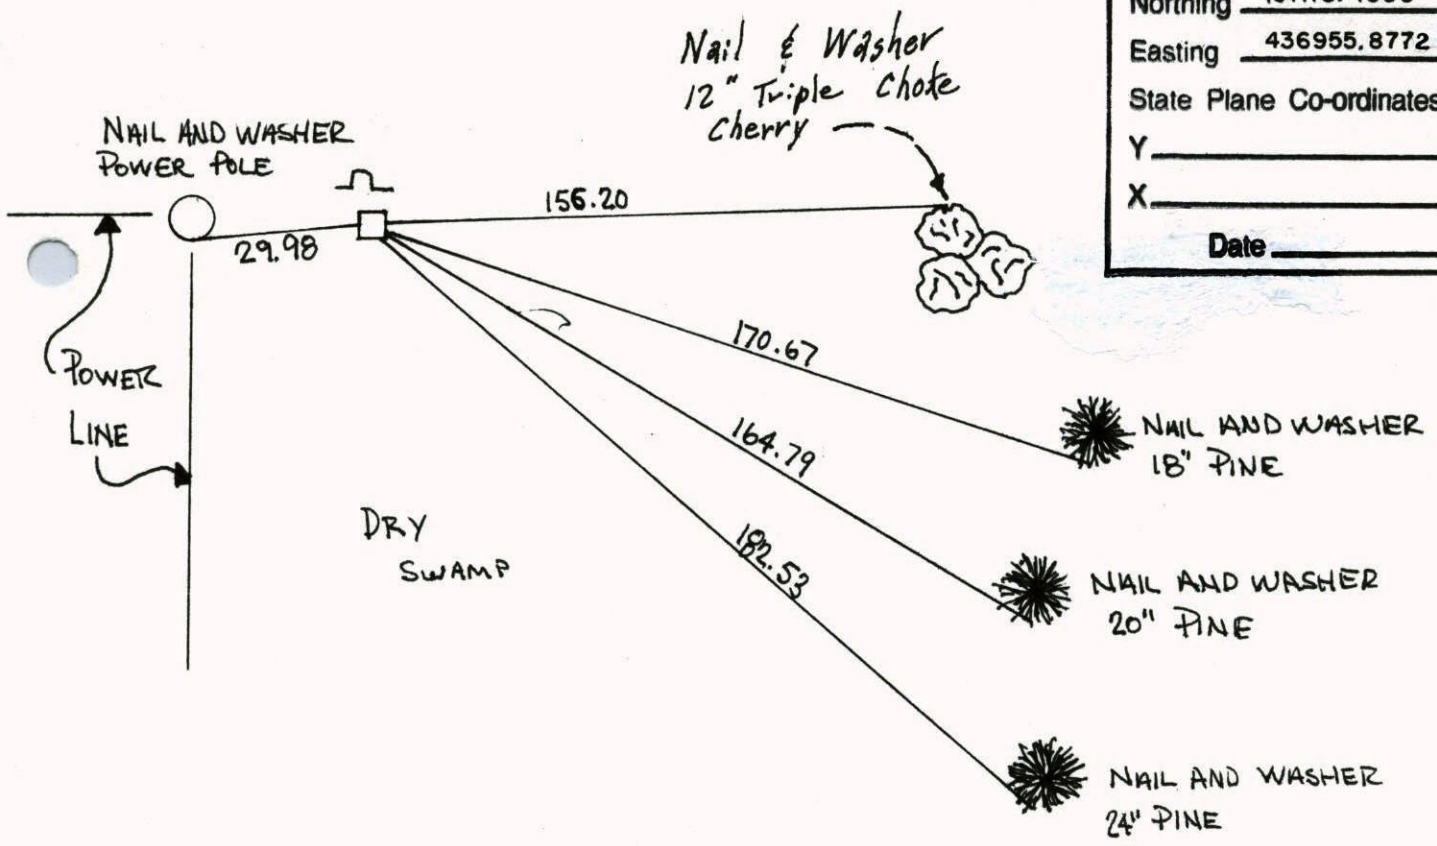


Revised date	Revised date	Revised date
<u>8-11-82</u>		
<u>7-19-85</u>		
<u>7-5-88</u>		
<u>8-6-93</u>		
<u>1-25-00</u>		

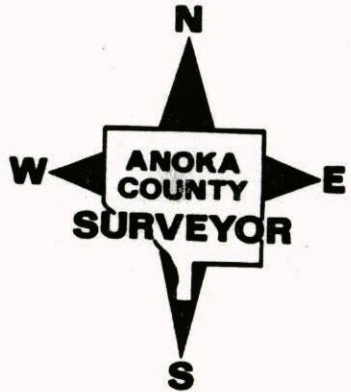


76.36

SOUTHWEST COR. SEC. 6 T. 32 R. 25
 RETIED MONUMENT DURING GPS

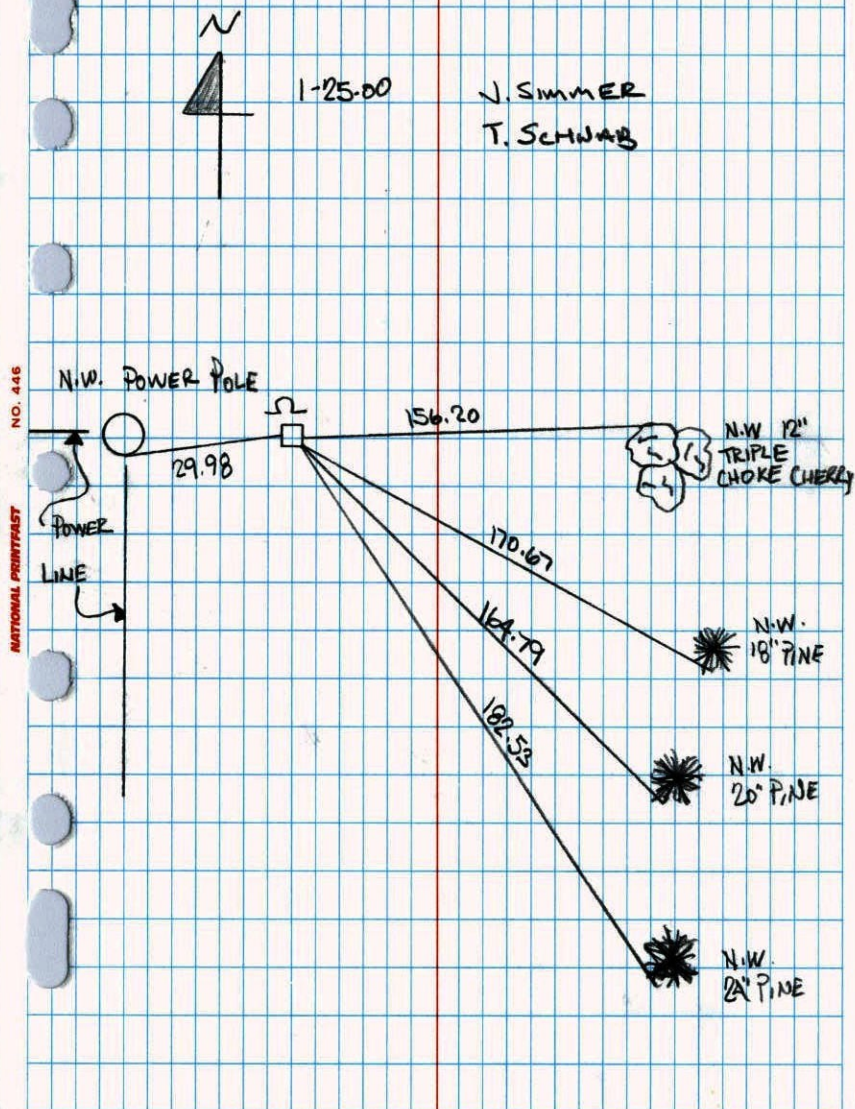


36

S.W. CORNER SEC 6 T32 R25
 RETIED GRANITE MONUMENT

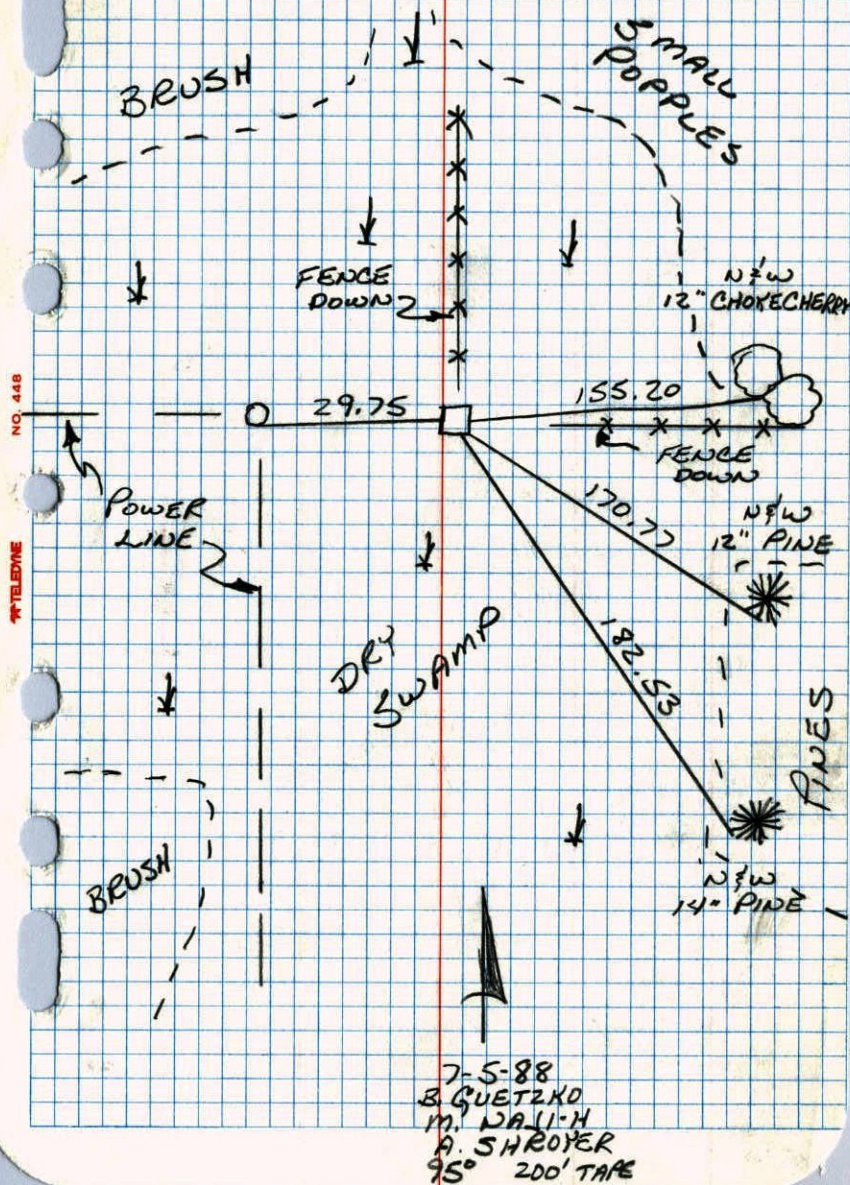

SW Cor. Sec. 6-T32-R25

Found 6"x6" Granite Monument up 0.6'±. Placed
yellow fence post on North Side up 3'±.

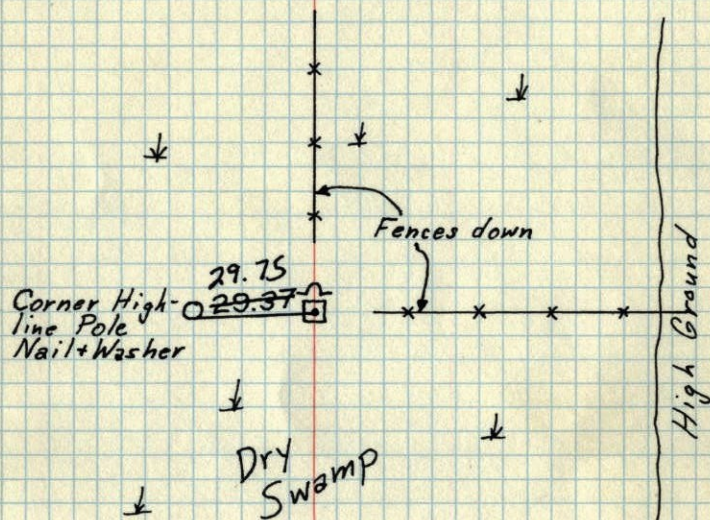

Tie Check	TIE CHECK
7/31/78	8-11-82
B. Olson	P. Ross
J. Baetcher	P. Hornby
R. Bauer	

Tie Check
6-22-76
G. Adams
B. Sannerud
S. Brien

Aug. 20, 1968
D. Powell
R. Olson
P. Pieh

Tie Check
6-18-79
Stephens
Stephens
Ross


TEMPERATURE CORRECTED
AND HORIZONTALLY
TAPED MEASUREMENTS

ROLAND W. ANDERSON
COUNTY SURVEYOR
ANOKA COUNTY, MINNESOTA

SW Cor. Sec. 6-T32-R25

Found 6"x6" Granite Mon. up 0.6'±.
Placed yellow fence post on N. side.

Should take additional ties in
winter.
Brush

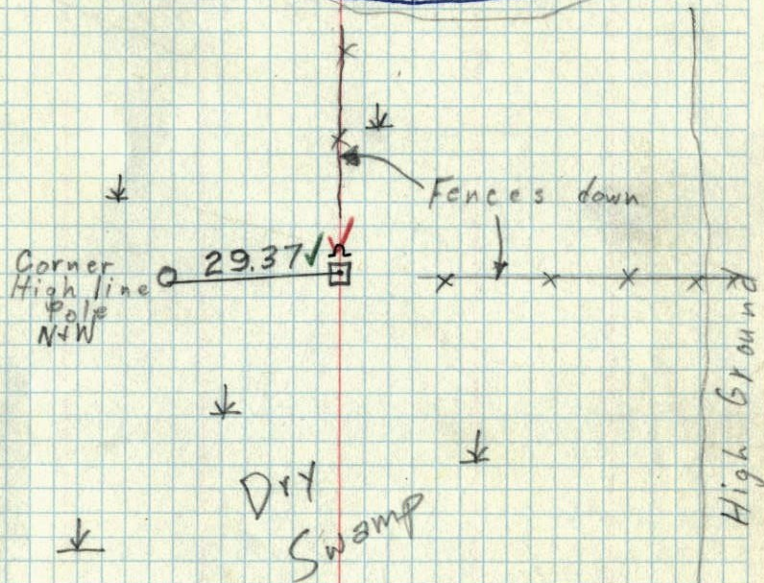

Noods

18/20/68
#6-750
D. Powell
R. Olson
P. Pieh

TREES