

# CERTIFICATE OF LOCATION OF GOVERNMENT CORNER

County of Anoka

State of Minnesota

NORTHEAST Corner of Sec. 17 Township 32 Range 25


I hereby certify that on the 18 day of APRIL, 1961, I found the described corner which was evidenced by 1/2" IRON PIPE

and I further certify that to perpetuate the location of said corner, I did, at the exact location thereof, place a permanent marker consisting of CAST IRON MONUMENT

(FLUSH)


WITH SIGN AND POST ON THE NORTH SIDE which reference or witness monuments are located in the manner following:

N.A.D.	1983	Co-ordinates
County	Project	Co-ordinates
Northing		185734.1551
Easting		447570.3385
State Plane Co-ordinates		
Y		
X		
Nail & Washer		Date <u>1/03/00</u>

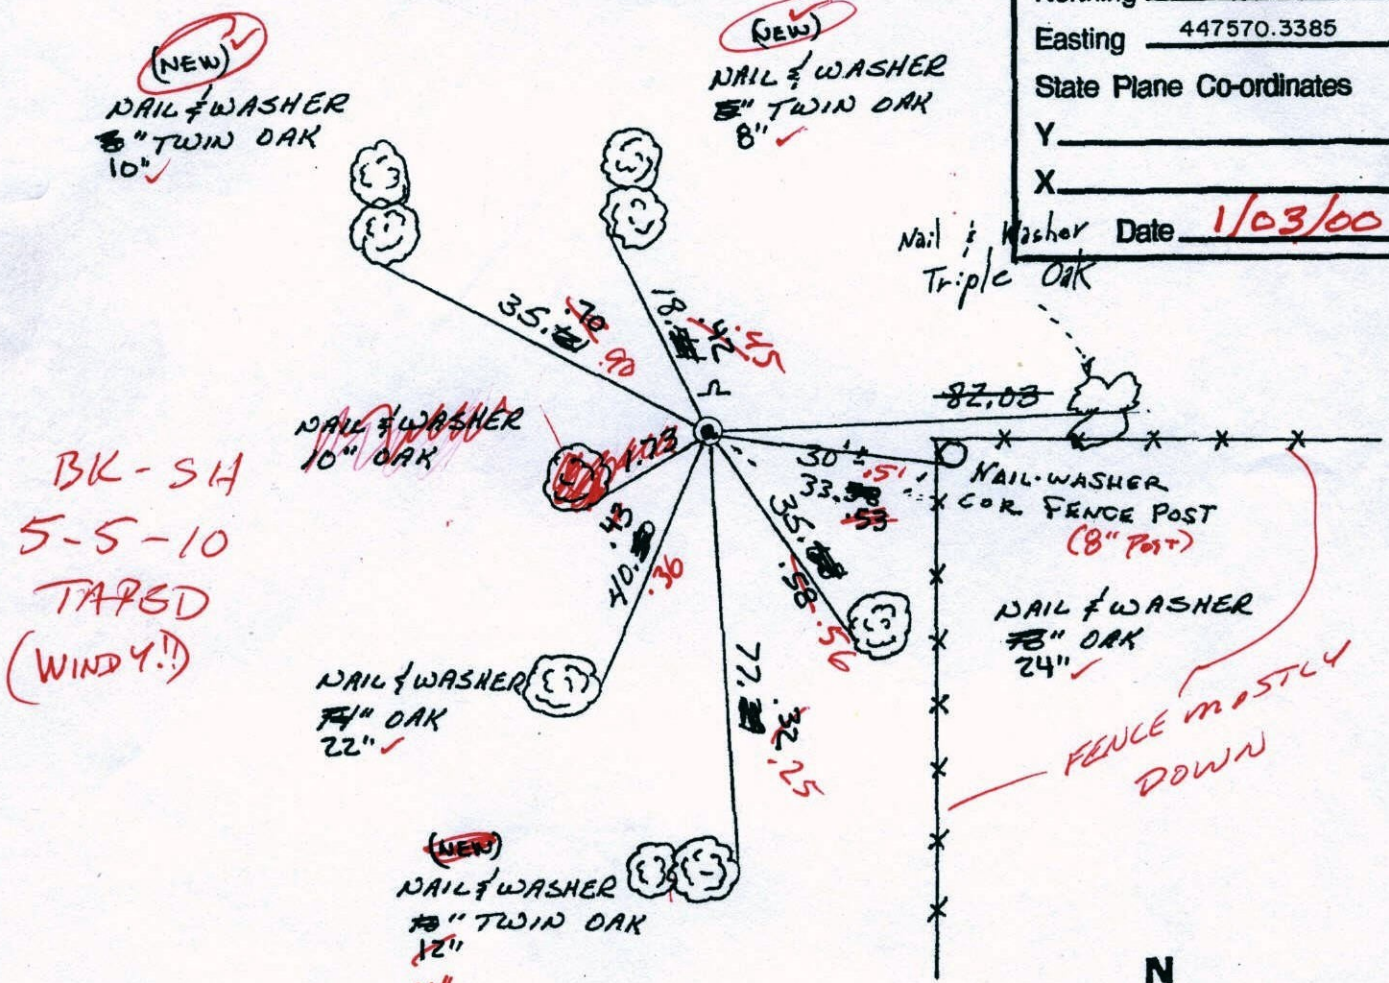

BK-SH  
5-5-10  
TAPSD  
(WINDY!)


Revised date	Revised date	Revised date
8-13-82		
7-30-85		
12-8-86		
6-23-88		
8-11-93		
1-3-00		

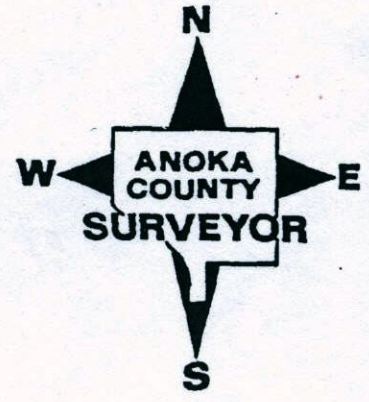



NE COR SEC 17 T32 R25


RETIED CAST IRON MONUMENT

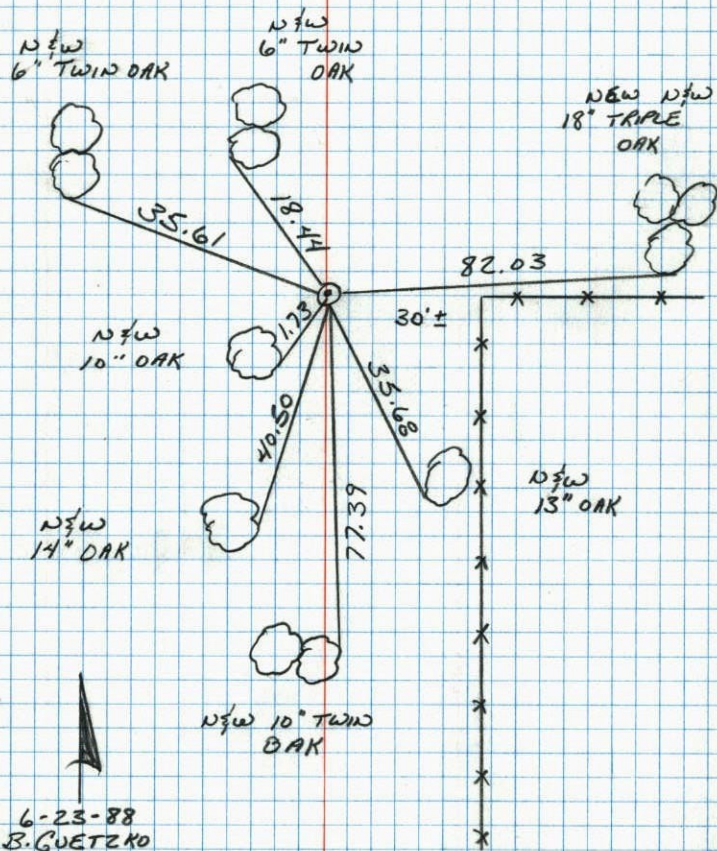

6-23-88  
B. GUETZKO  
M. NAJI-H  
70° 200' TAPE

N.E. CORNER SECTION 17-T32-R25

SET CAST IRON MONUMENT AT LOCATION OF FOUND  
1/2" IRON PIPE.  
18 APR 61  
FREEMAN  
ANDERSON

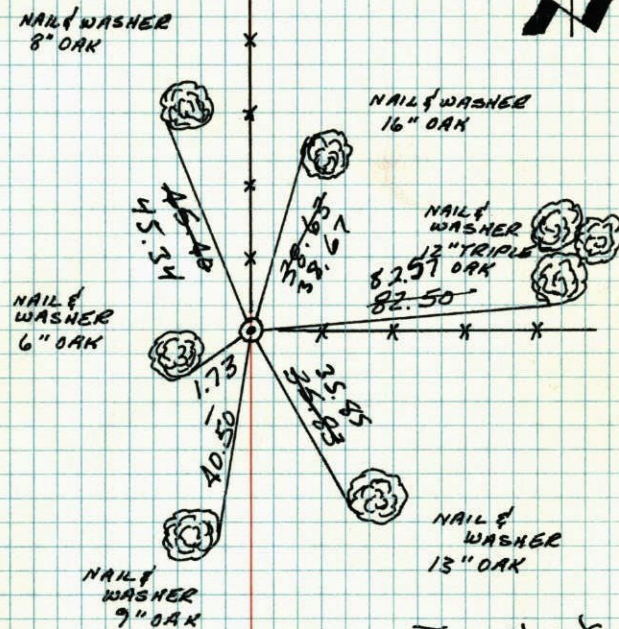

TIE CHECK  
28 JUN 76  
G. ADAMS  
B. SANNEKUD  
S. BRIEN

TIE CHECK  
8-13-82  
P. ROSS  
P. HORNBY

Tie check  
6-19-79  
Stephens  
Stephens  
Ross

TEMPERATURE CORRECTED AND HORIZONTALLY  
TAPED MEASUREMENTS

ROLAND W. ANDERSON  
COUNTY SURVEYOR  
ANOKA COUNTY, MINNESOTA

N.E. COR. SEC. 17-32-25

Found Iron Pipe (1/2") down 0.4'

Replaced iron pipe with cast

Iron man. up 0.1'

6-11-69

D. Powell

R. Olson

B. Olson


Tie Check

6-28-70

G. Adams

B. Sommerud

J. Brien

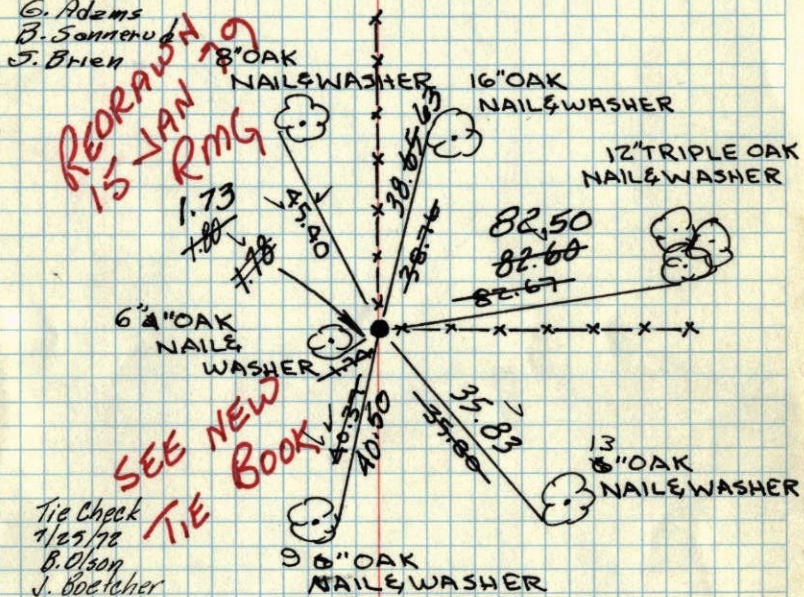


Retie 8/5/64

APRIL 18, 1961


M. D. Anderson  
R. CarlsonR. FREEMAN  
M. ANDERSONTEMPERATURE CORRECTED  
AND HORIZONTALLY  
TAPED MEASUREMENTSROLAND W. ANDERSON  
COUNTY SURVEYOR  
ANOKA COUNTY, MINNESOTA18 April 1961  
Freeman Anderson  
+ 50°

NE Cor Sec 17-32-25 Ramsey

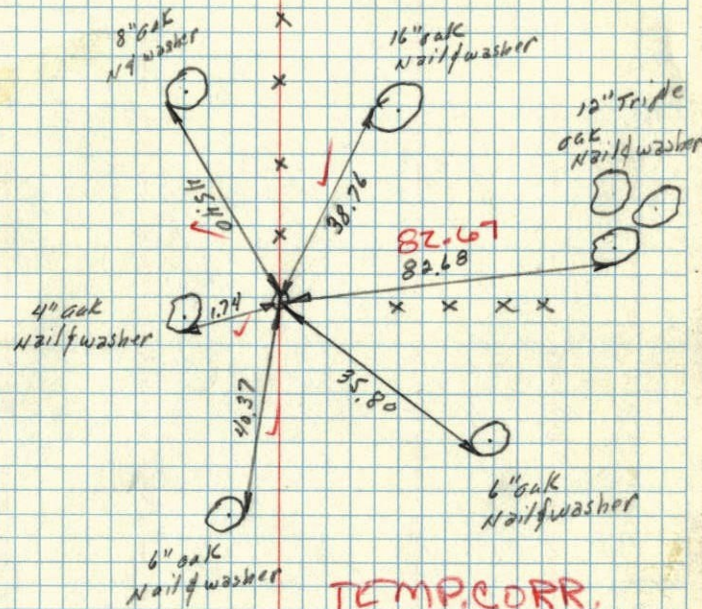Found 1/2" iron by Egan-Field & Howak (1952)  
2 old ties remain.

10 ✓  
N.E. CORNER OF SEC. 17 T32 R25

IRON

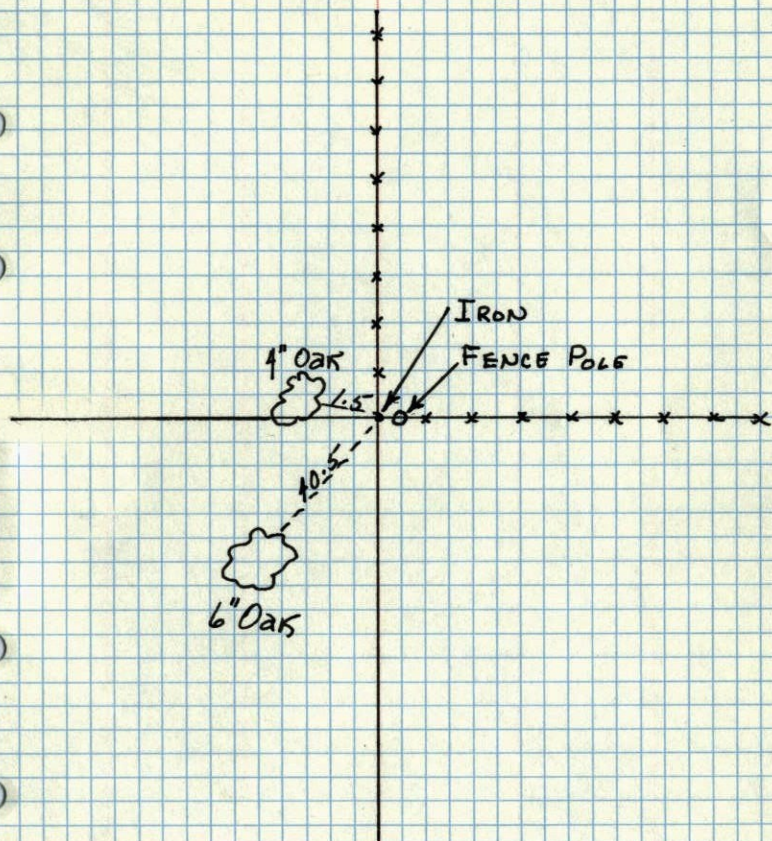

May 1952  
Egan Field & Novak