


SE Sec. 36 - 32 - 25

11/7/45 OLD GRANITE Down 6"
in River Bed

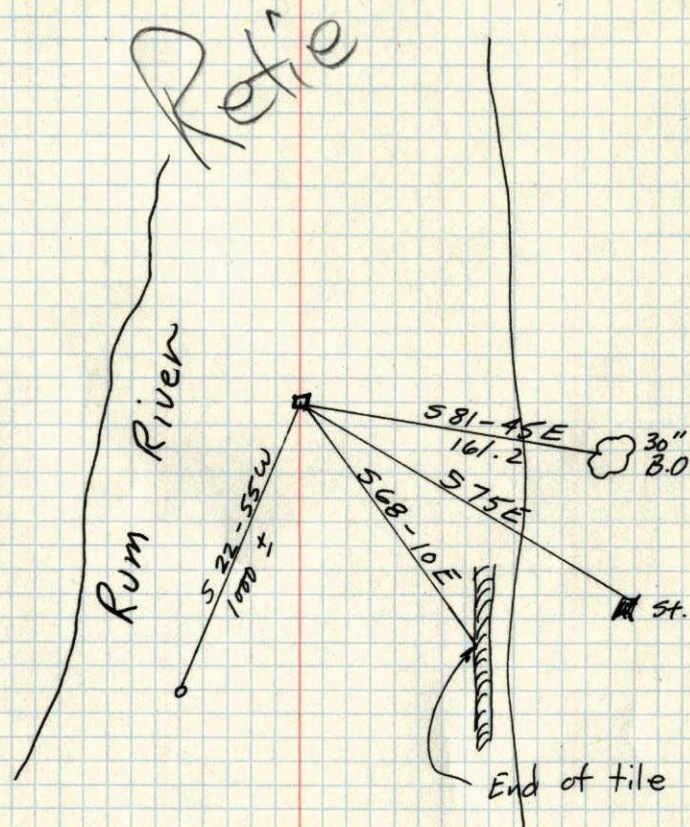

Hovum