

CERTIFICATE OF LOCATION OF GOVERNMENT CORNER

County of Anoka

State of Minnesota



North $\frac{1}{4}$ Corner of Sec. 2 Township 32 Range 25

On the 12th day of August, 1960, the described corner was evidenced by a granite monument with an iron pipe on the north side

and to perpetuate the location of said corner, at the exact location thereof, a permanent marker was placed consisting of the same granite monument leaning North (ties were measured to the leaning position)

AND on the 28th day of September, 2015, said permanent marker was found down 0.3' and leaning South in a triangular shaped buried tire. Updated ties were measured to leaning position.

Updated reference ties are as shown below.

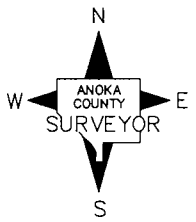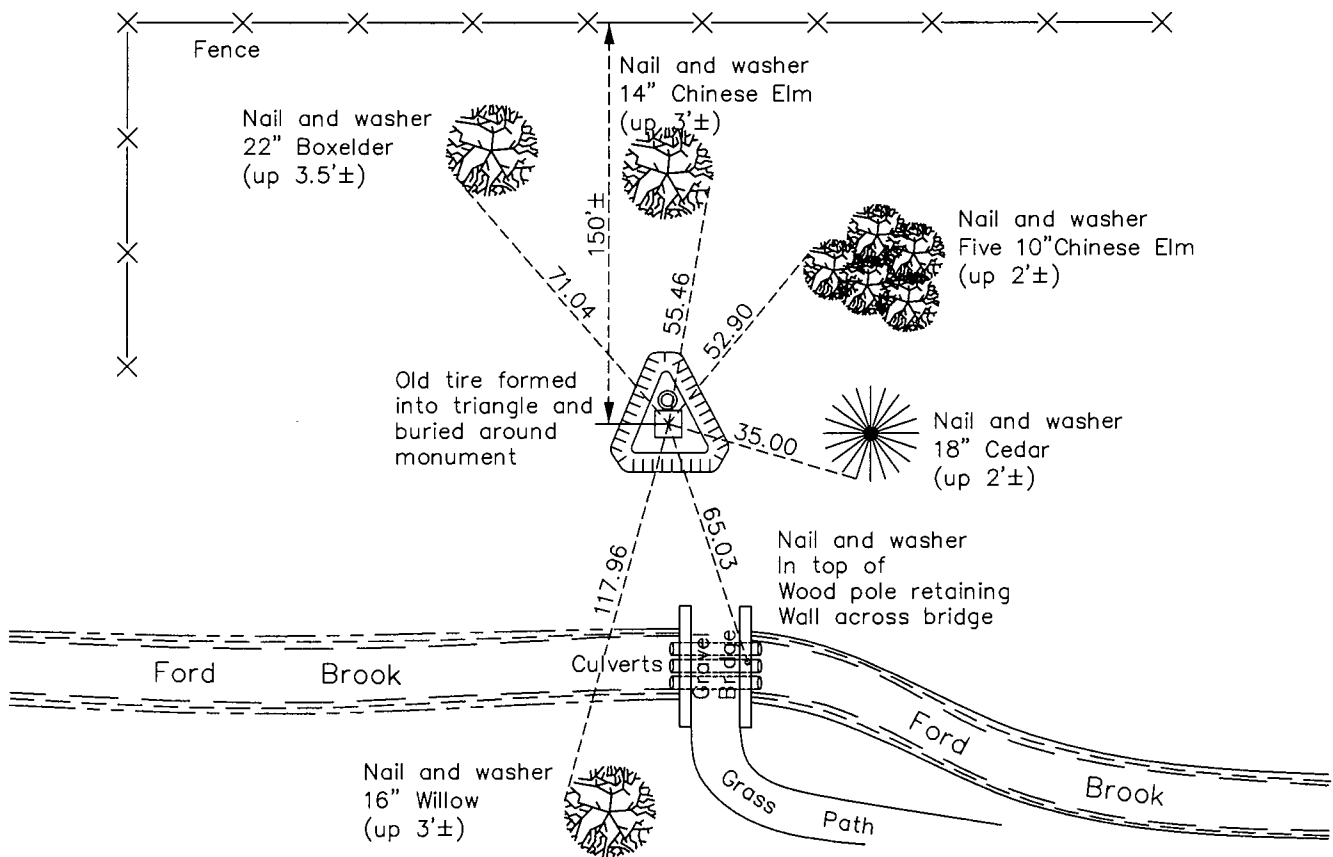

Revision Date
7/14/16

N.A.D. 1983 Coordinates
(1996 Adjustment)

County Project Coordinates	
Northing	196234.9786
Easting	460811.8544
Date	2/28/00

I hereby certify that this United States public land survey monument record is correct and complete to the best of my knowledge and belief.

Larry D. Hoium Date 8/11/16

Larry D. Hoium, Anoka County Surveyor

Minnesota License Number 18165

HISTORY OF GOVERNMENT CORNER

County of Anoka

State of Minnesota

North 1/4 Corner of Sec. 2 Township 32 Range 25

CORNER HISTORY:

March 23, 1948 - Jackson found granite monument with an iron pipe on the north side and established ties to monument.

August 12, 1960 - Found granite monument flush with the surface and with an iron pipe on the north side. Updated ties.

August 10, 1964 - Found granite monument with an iron pipe on the north side and updated ties.

June 9, 1969 - Found granite monument with an iron pipe on the north side and updated ties.

July 19, 1972 - Found granite monument with an iron pipe on the north side and updated ties.

June 18, 1976 - Found granite monument with an iron pipe on the north side and updated ties.

June 27, 1979 - Found granite monument with an iron pipe on the north side and updated ties.

August 18, 1982 - Found granite monument with an iron pipe on the north side and updated ties.

July 30, 1985 - Found granite monument with an iron pipe on the north side and updated ties.

July 5, 1988 - Found granite monument with an iron pipe on the north side and updated ties. Monument is leaning north but fit existing ties.

August 23, 1993 - Found granite monument with an iron pipe on the north side and updated ties to leaning position.

February 28, 2000 - Found granite monument with an iron pipe on the north side and established NAD 1983 (1996 Adjustment) Anoka County Project Coordinates by Static GPS methods to leaning position. Updated ties to leaning position.

June 1, 2010 - Found granite monument down 0.3'± with an iron pipe on the north side inside a tire triangle and leaning south. Updated ties to leaning position.

September 28, 2015 - Found granite monument down 0.3'± with an iron pipe on the north side inside a triangular shaped buried tire and leaning south. Updated ties to leaning position.