

CERTIFICATE OF LOCATION OF GOVERNMENT CORNER

County of Anoka

State of Minnesota



North $\frac{1}{4}$ Corner of Sec. 3 Township 32 Range 25

On the 17th day of June, 1963, the described corner was evidenced by a notched field stone with a $\frac{3}{4}$ " iron pipe under the stone

and to perpetuate the location of said corner, at the exact location thereof, a permanent marker was placed consisting of the same field stone with a sign and post on the south side

AND on the 28th day of September, 2015, said permanent marker was found $\frac{1}{2}$ " iron pipe on the north side of stone. Ties were updated

Updated reference ties are as shown below.

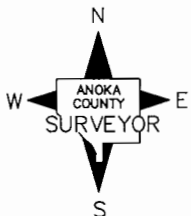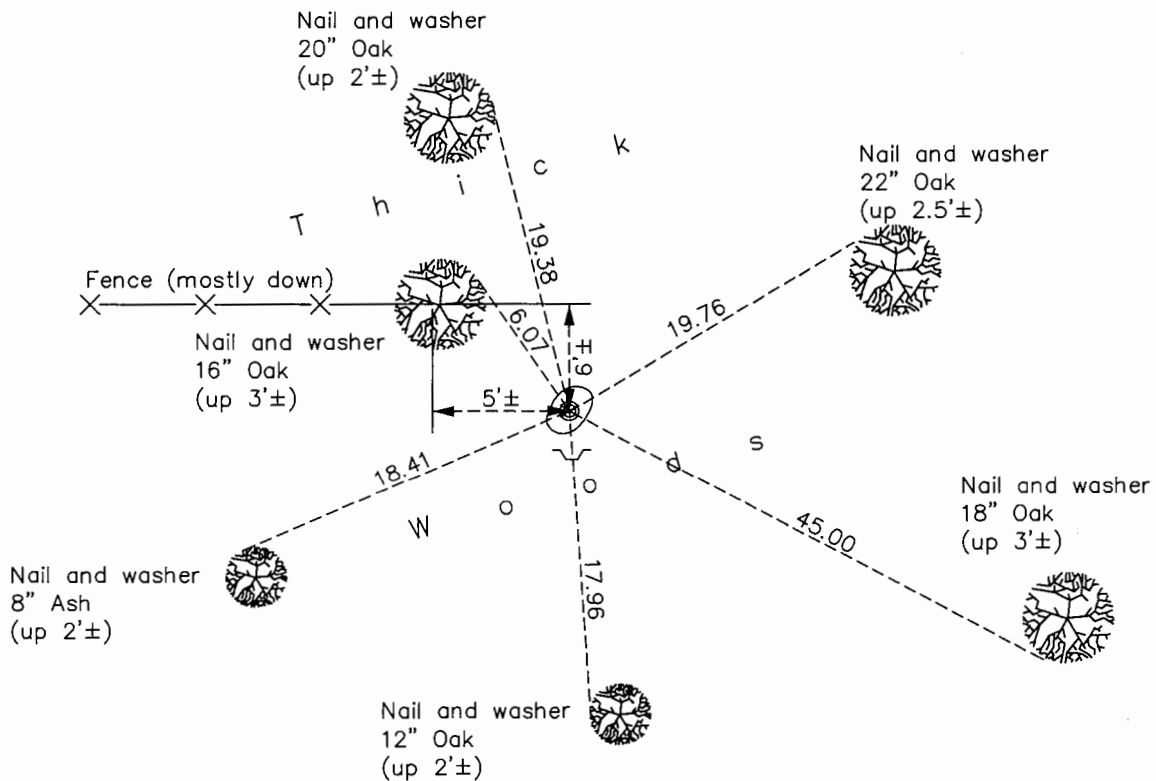

Revision Date

7/14/16

N.A.D. 1983 Coordinates
(1996 Adjustment)

County Project Coordinates	
Northing	<u>196304.7805</u>
Easting	<u>455574.0884</u>
Date	<u>3/02/00</u>

I hereby certify that this United States public land survey monument record is correct and complete to the best of my knowledge and belief.

Larry D. Hoium Date 8/25/16

Larry D. Hoium, Anoka County Surveyor

Minnesota License Number 18165

HISTORY OF GOVERNMENT CORNER

County of Anoka

State of Minnesota

North 1/4 Corner of Sec. 3 Township 32 Range 25

CORNER HISTORY:

June 13, 1961 - N.C. Hoium and Associates, Inc. found notched field stone. Set 1/2" iron pipe on north side of stone and established ties to monument.

June 17, 1963 - Found notched field stone using N.C. Hoium and Associates, Inc. ties and updated ties. Set 3/4" iron pipe underneath field stone.

August 10, 1964 - Found notched field stone with 3/4" iron pipe on north side of stone and updated ties.

June 18, 1969 - Found notched field stone with 3/4" iron pipe on north side of stone and updated ties.

July 25, 1972 - Found notched field stone with 3/4" iron pipe on north side of stone and updated ties. Stone is 4'± east and 5'± south of fences.

July 3, 1979 - Found notched field stone with 3/4" iron pipe on north side of stone and updated ties .

August 18, 1982 - Found notched field stone with 3/4" iron pipe on north side of stone and updated ties .

July 31, 1985 - Found notched field stone with 3/4" iron pipe on north side of stone and updated ties .

July 5, 1988 - Found notched field stone with 3/4" iron pipe underneath the stone and updated ties .

August 23, 1993 - Found notched field stone with 3/4" iron pipe underneath the stone and updated ties .

March 2, 2000 - Found notched field stone and established NAD 1983 (1996 Adjustment) Anoka County Project Coordinates by Static GPS methods. Updated ties. Also found sign and post on south side of stone, date set unknown.

June 9, 2010 - Found notched field stone with 3/4" iron pipe underneath the stone and with a sign and post on the south side. Updated ties .

September 28, 2015 - Found notched field stone with a 1/2" iron pipe on the north side of stone and a sign and post on the south side. Updated ties .