

# CERTIFICATE OF LOCATION OF GOVERNMENT CORNER

County of Anoka

State of Minnesota



Witness Corner of Sec. 19 Township 32 Range 25  
 (On north line of section)

On the 13th day of June, 1968, the described corner was evidenced by area resurvey

and to perpetuate the location of said corner, at the exact location thereof, a permanent marker was placed consisting of a cast iron monument with a sign and post on the north side

AND on the 6th day of October, 2015, said permanent marker was found down 0.2'± and the ties were updated

Updated reference ties are as shown below.

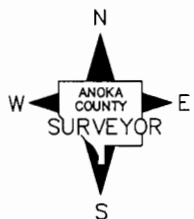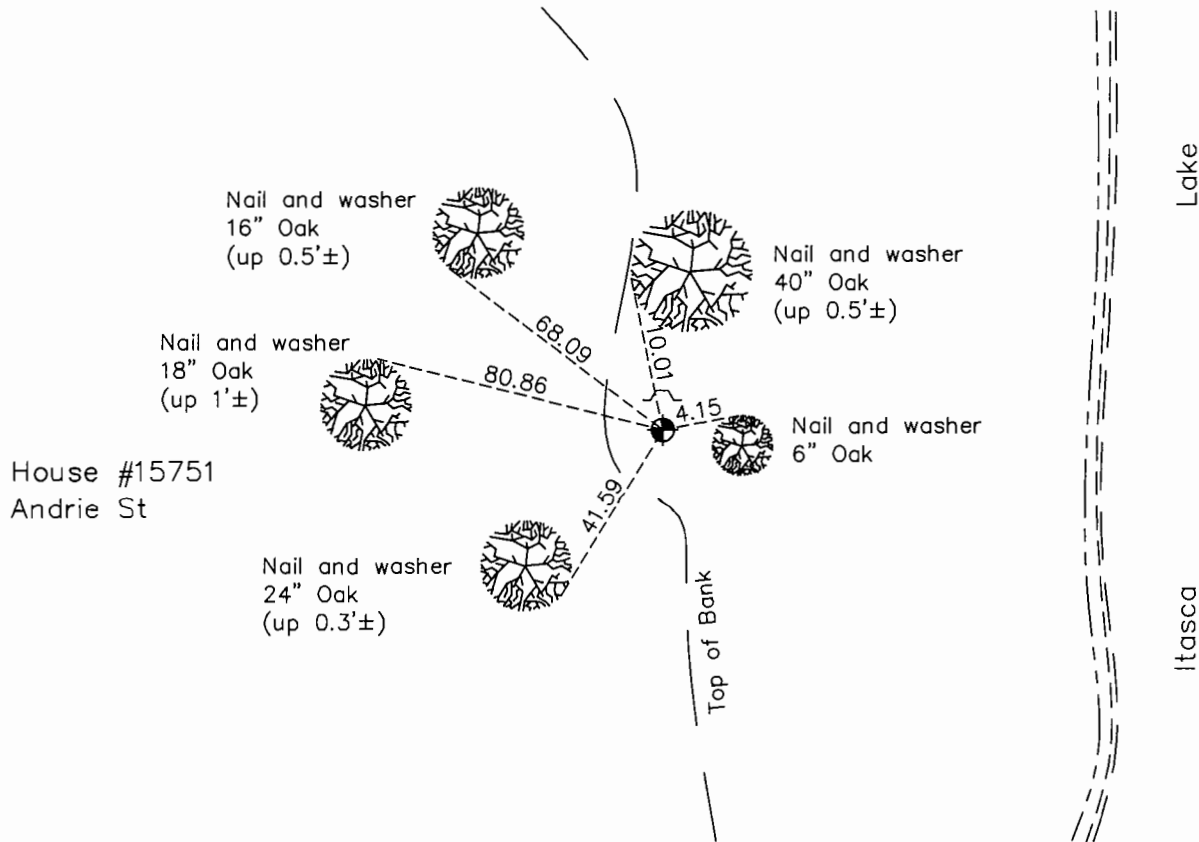

Revision Date  
8/10/16

N.A.D. 1983 Coordinates  
 (1996 Adjustment)

| County Project Coordinates |                    |
|----------------------------|--------------------|
| Northing                   | <u>180533.3446</u> |
| Easting                    | <u>440171.0180</u> |
| Date                       | <u>4/25/00</u>     |

I hereby certify that this United States public land survey monument record is correct and complete to the best of my knowledge and belief.

*Larry D. Hoium* Date 8/25/16

Larry D. Hoium, Anoka County Surveyor  
 Minnesota License Number 18165

# HISTORY OF GOVERNMENT CORNER

County of Anoka

State of Minnesota

Witness Corner of Sec. 19 Township 32 Range 25  
(On north line of section)

**CORNER HISTORY:**

June 13, 1968 - Set cast iron monument flush with the surface using area resurvey and established ties to monument.

June 16, 1969 - Found cast iron monument and updated ties.

August 1, 1972 - Found cast iron monument and updated ties.

July 2, 1976 - Found cast iron monument and updated ties.

July 6, 1979 - Found cast iron monument and updated ties.

August 12, 1982 - Found cast iron monument and updated ties.

July 25, 1985 - Found cast iron monument and updated ties.

June 10, 1988 - Found cast iron monument and updated ties.

August 11, 1993 - Found cast iron monument and updated ties.

May 8, 1996 - Found cast iron monument and updated ties.

April 25, 2000 - Found cast iron monument with a sign and post on the north side and established NAD 1983 (1996 Adjustment) Anoka County Project Coordinates by Static GPS methods. Updated ties.

May 3, 2010 - Found cast iron monument with a sign and post on the north side and updated ties.

October 6, 2015 - Found cast iron monument down 0.2'± with a sign and post on the north side and updated ties.