

CERTIFICATE OF LOCATION OF GOVERNMENT CORNER

County of Anoka

State of Minnesota



Witness Corner of Sec. 28 Township 32 Range 25
 (On west line of SW1/4)

On the 9th day of September, 1975, the described corner was evidenced by area resurvey

and to perpetuate the location of said corner, at the exact location thereof, a permanent marker was placed consisting of a cast iron monument

AND on the 20th day of October, 2015, said permanent marker was found down 0.5'± and the ties were updated

Updated reference ties are as shown below.

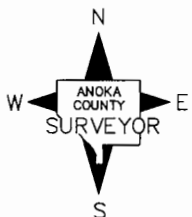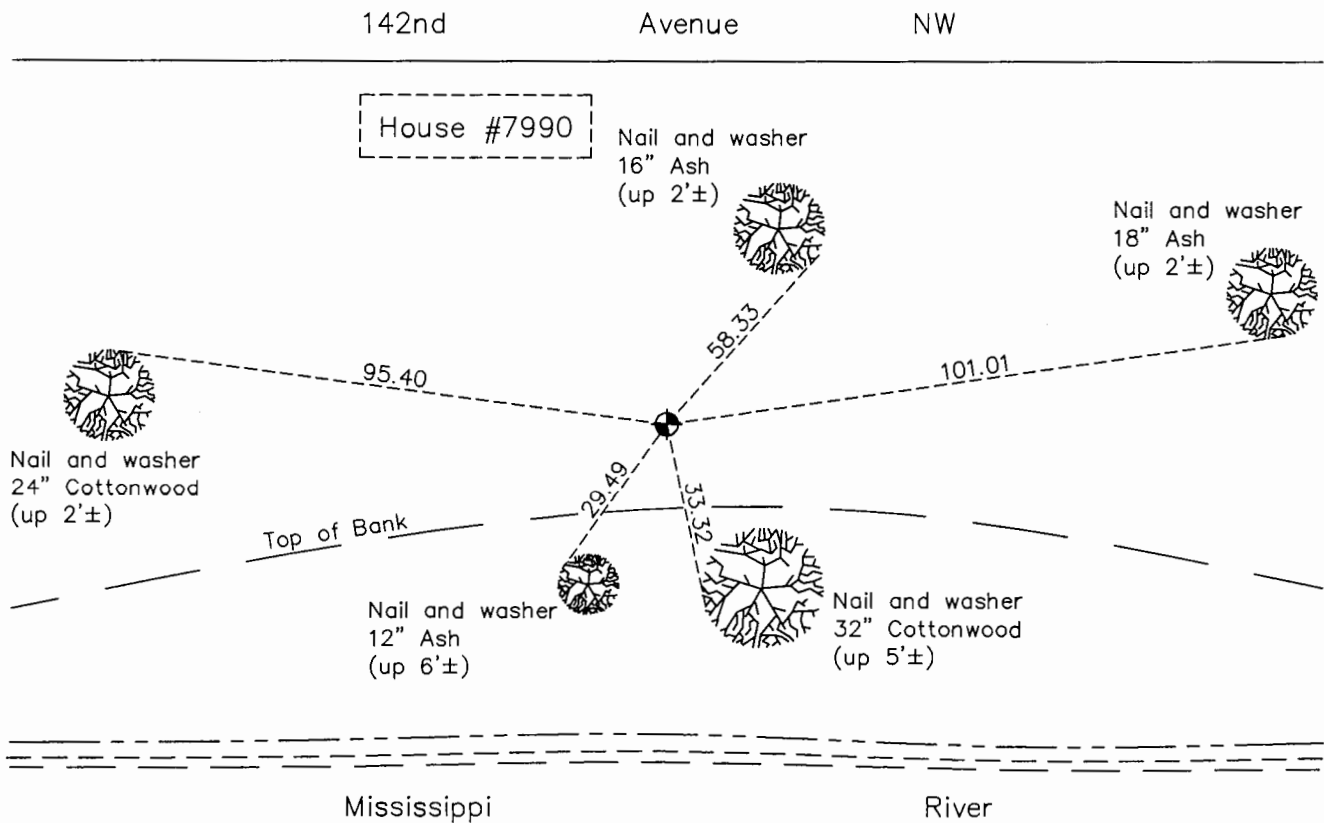

Revision Date
8/17/16

N.A.D. 1983 Coordinates
 (1996 Adjustment)

County Project Coordinates	
Northing	170085.1261
Easting	447528.5393
Date	12/22/99

I hereby certify that this United States public land survey monument record is correct and complete to the best of my knowledge and belief.

Larry D. Hoium Date 8/30/16

Larry D. Hoium, Anoka County Surveyor

Minnesota License Number 18165

HISTORY OF GOVERNMENT CORNER

County of Anoka

State of Minnesota

Witness Corner of Sec. 28 Township 32 Range 25
(On west line of SW1/4)

CORNER HISTORY:

September 9, 1975 - Set cast iron monument flush with the surface using area resurvey and established ties to monument. Set sign and post on south side of monument.

July 8, 1976 - Found cast iron monument and updated ties.

June 22, 1979 - Found cast iron monument and updated ties.

August 1, 1985 - Found cast iron monument and updated ties.

June 27, 1988 - Replaced cast iron monument using two remaining ties and updated ties.

August 20, 1993 - Found cast iron monument and updated ties.

December 22, 1999 - Found cast iron monument and established NAD 1983 (1996 Adjustment) Anoka County Project Coordinates by Static GPS methods. Updated ties.

May 25, 2010 - Found cast iron monument and updated ties.

October 20, 2015 - Found cast iron monument down 0.5'± and updated ties.