

# CERTIFICATE OF LOCATION OF GOVERNMENT CORNER

County of Anoka

State of Minnesota



Witness Corner of Sec. 34 Township 32 Range 25  
 (On west line of section)

On the 16th day of April, 1962, the described corner was evidenced by a 4"X4"  
concrete monument

and to perpetuate the location of said corner, at the exact location thereof, a permanent marker was placed consisting of the same concrete monument with a 1" iron pipe on the north side and a sign and post on the south side

AND on the 8th day of October, 2015, said permanent marker was found flush with the surface and the ties were updated

Updated reference ties are as shown below.

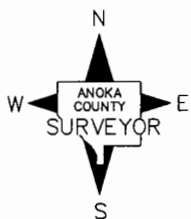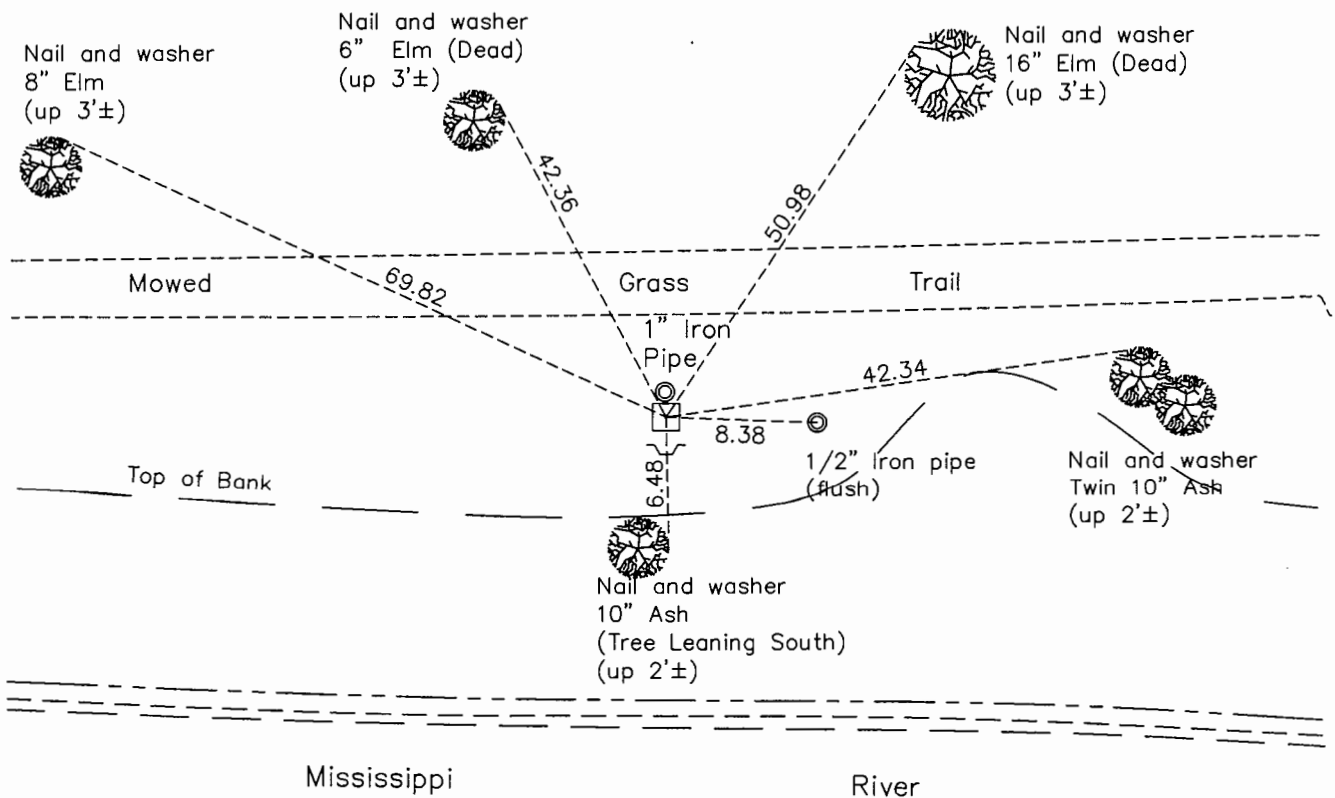

Revision Date  
8/18/16

N.A.D. 1983 Coordinates  
 (1996 Adjustment)

County Project Coordinates	
Northing	<u>167278.6310</u>
Easting	<u>452832.6778</u>
Date	<u>1/11/01</u>

I hereby certify that this United States public land survey monument record is correct and complete to the best of my knowledge and belief.

*Larry D. Hoium* Date 8/30/16

Larry D. Hoium, Anoka County Surveyor

Minnesota License Number 18165

# HISTORY OF GOVERNMENT CORNER

County of Anoka

State of Minnesota

Witness Corner of Sec. 34 Township 32 Range 25  
(On west line of section)

**CORNER HISTORY:**

May 10, 1944 - Cartwright found concrete monument and established ties to monument.

April 16, 1962 - Found 4" square concrete monument flush with the surface and updated ties. Set 1" iron pipe up 2'± and painted red on north side of monument.

August 12, 1964 - Found concrete monument and updated ties. Iron pipe is missing.

June 30, 1969 - Found concrete monument and updated ties . Set 1" iron pipe up 2'± and painted yellow on north side of monument.

August 22, 1972 - Found concrete monument and updated ties .

July 8, 1976 - Found concrete monument and updated ties .

July 5, 1979 - Found concrete monument and updated ties .

August 17, 1982 - Found concrete monument and updated ties .

July 29, 1985 - Found concrete monument and updated ties .

June 28, 1988 - Found concrete monument with 1" iron pipe up 2'± on north side and updated ties .

August 20, 1993 - Found concrete monument and updated ties .

April 25, 1995 - Found concrete monument and updated ties .

January 11, 2001 - Found 4" X 4" concrete monument with a 1" iron pipe on north side of monument and a sign and post on the south side. Established NAD 1983 ( 1996 Adjustment) Anoka County Project Coordinates by Static GPS methods. Updated ties.

May 17, 2010 - Found concrete monument with a sign and post on the south side and updated ties .

October 8, 2015 - Found concrete monument flush with the surface with a sign and post on the south side and updated ties.