

CERTIFICATE OF LOCATION OF GOVERNMENT CORNER

County of Anoka

State of Minnesota



South 1/4 Corner of Sec. 35 Township 32 Range 25

On the 5th day of January, 1961, the described corner was evidenced by an old bed post

and to perpetuate the location of said corner, at the exact location thereof, a permanent marker was placed consisting of a cast iron monument with a sign and post 1'± north of monument

AND on the 2nd day of October, 2015, said permanent marker was found flush and the ties were updated

Updated reference ties are as shown below.

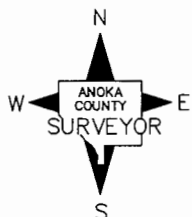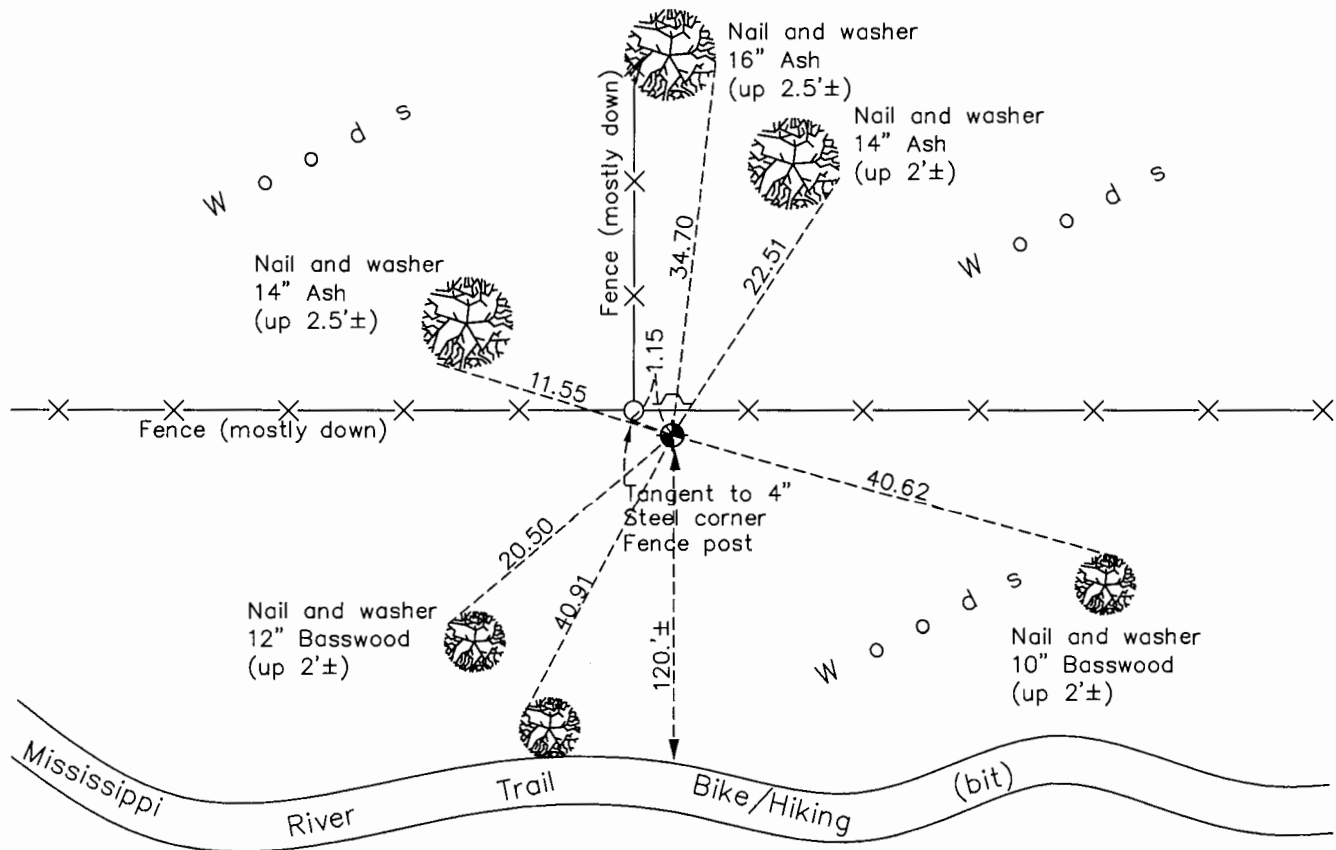

Revision Date

8/18/16

N.A.D. 1983 Coordinates
(1996 Adjustment)

County Project Coordinates	
Northing	164648.5799
Easting	460620.2686
Date	1/11/01

I hereby certify that this United States public land survey monument record is correct and complete to the best of my knowledge and belief.

Larry D. Hoium Date 8/30/16

Larry D. Hoium, Anoka County Surveyor
Minnesota License Number 18165

HISTORY OF GOVERNMENT CORNER

Page No. 134

County of Anoka

State of Minnesota

South 1/4 Corner of Sec. 35 Township 32 Range 25

CORNER HISTORY:

January 5, 1961 - Found old bed post up 0.3'± at intersection of fences and established ties to post.

August 28, 1967 - Replaced old bed post with a cast iron monument set flush with the surface. Updated ties.

July 1, 1969 - Found cast iron monument and updated ties.

July 15, 1976 - Found cast iron monument and updated ties.

July 2, 1979 - Found cast iron monument and updated ties.

August 17, 1982 - Found cast iron monument and updated ties.

July 6, 1988 - Found cast iron monument with a sign and post on the north side and updated ties.

August 20, 1993 - Found cast iron monument and updated ties.

January 11, 2001 - Found cast iron monument and established NAD 1983 (1996 Adjustment) Anoka County Project Coordinates by Static GPS methods. Updated ties.

May 19, 2010 - Found cast iron monument flush with the surface with a sign and post 1'± north of monument and updated ties.

October 2, 2015 - Found cast iron monument flush with the surface with a sign and post 1'± north of monument and updated ties.