

CERTIFICATE OF LOCATION OF GOVERNMENT CORNER

County of Anoka

State of Minnesota



Southwest Corner of Sec. 15 Township 33 Range 22

On the 31st day of July, 1975, the described corner was evidenced by a concrete monument

and to perpetuate the location of said corner, at the exact location thereof, a permanent marker was placed consisting of a cast iron monument

AND on the 30th day of August, 2017, said permanent marker was found broken. Replaced w/ 2"X7' sq. steel Telespar mont. down 0.5'± w/ "Co. Surveyor" cap & punchmark. No ties available.

Updated reference ties are as shown below.

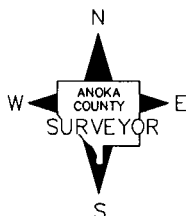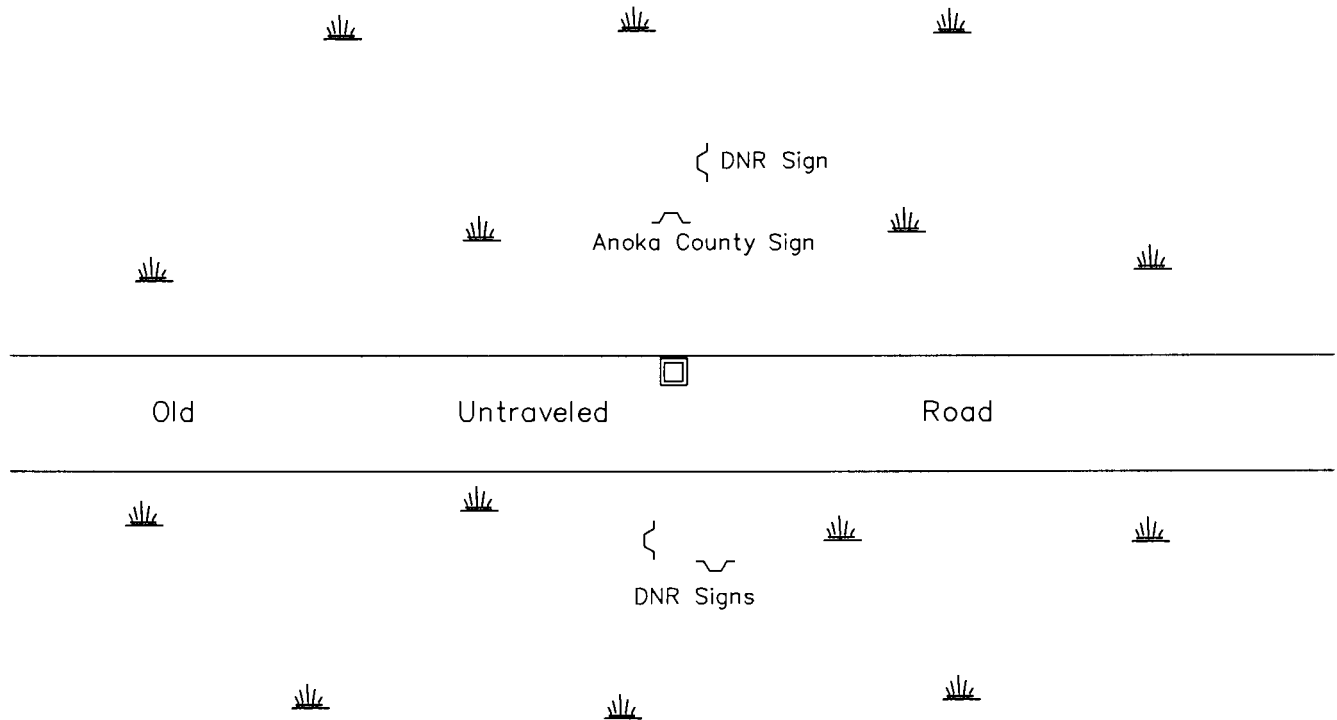

Revision Date

12/28/17

N.A.D. 1983 Coordinates
(1996 Adjustment)

County Project Coordinates	
Northing	<u>211400.5990</u>
Easting	<u>547488.1303</u>
Date	<u>4/28/04</u>

I hereby certify that this United States public land survey monument record is correct and complete to the best of my knowledge and belief.

Larry D. Hoium Date 12/28/17

Larry D. Hoium, Anoka County Surveyor

Minnesota License Number 18165