

CERTIFICATE OF LOCATION OF GOVERNMENT CORNER

County of Anoka

State of Minnesota



South 1/4 Corner of Sec. 16 Township 33 Range 22

On the 4th day of August, 1975, the described corner was evidenced by a concrete monument

and to perpetuate the location of said corner, at the exact location thereof, a permanent marker was placed consisting of a cast iron monument

AND on the 30th day of August, 2017, said permanent marker was found broken. Replaced w/ 2"X7' sq. steel Telespar mont. down 0.5'± w/ "Co. Surveyor" cap & punchmark. No ties available.

Updated reference ties are as shown below.

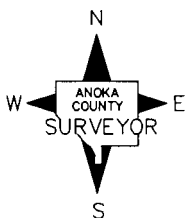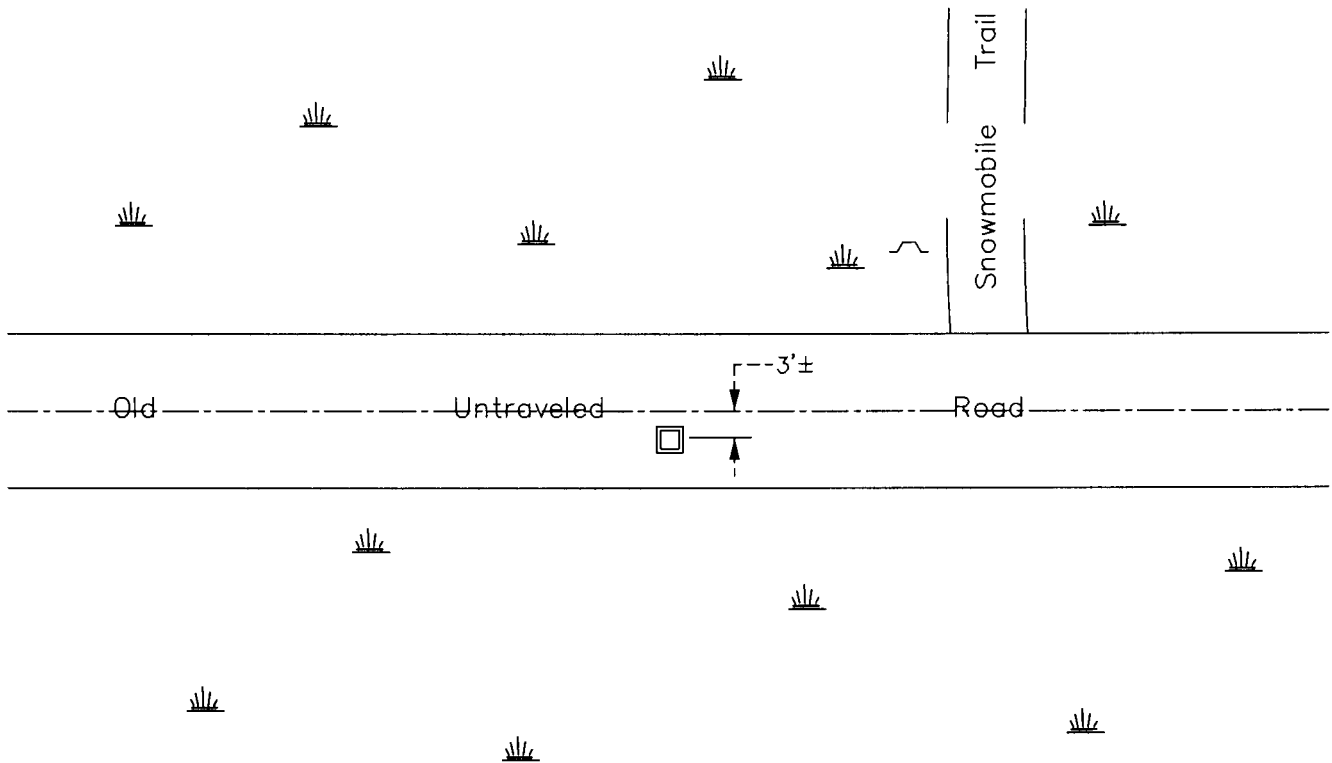

Revision Date

12/28/17

N.A.D. 1983 Coordinates
(1996 Adjustment)

County Project Coordinates	
Northing	<u>211326.1830</u>
Easting	<u>544813.4321</u>
Date	<u>5/03/04</u>

I hereby certify that this United States public land survey monument record is correct and complete to the best of my knowledge and belief.

Larry D. Hoium Date 12/28/17

Larry D. Hoium, Anoka County Surveyor

Minnesota License Number 18165