

CERTIFICATE OF LOCATION OF GOVERNMENT CORNER

County of Anoka

State of Minnesota



East 1/4 Corner of Sec. 24 Township 31 Range 24

On the 26th day of June, 1964, the described corner was evidenced by a concrete monument and a 1" iron pipe

and to perpetuate the location of said corner, at the exact location thereof, a permanent marker was placed consisting of a cast iron monument

AND on the 16th day of October, 2017, said permanent marker was replaced with a new cast iron monument after road construction and the ties were updated

Updated reference ties are as shown below.

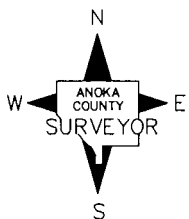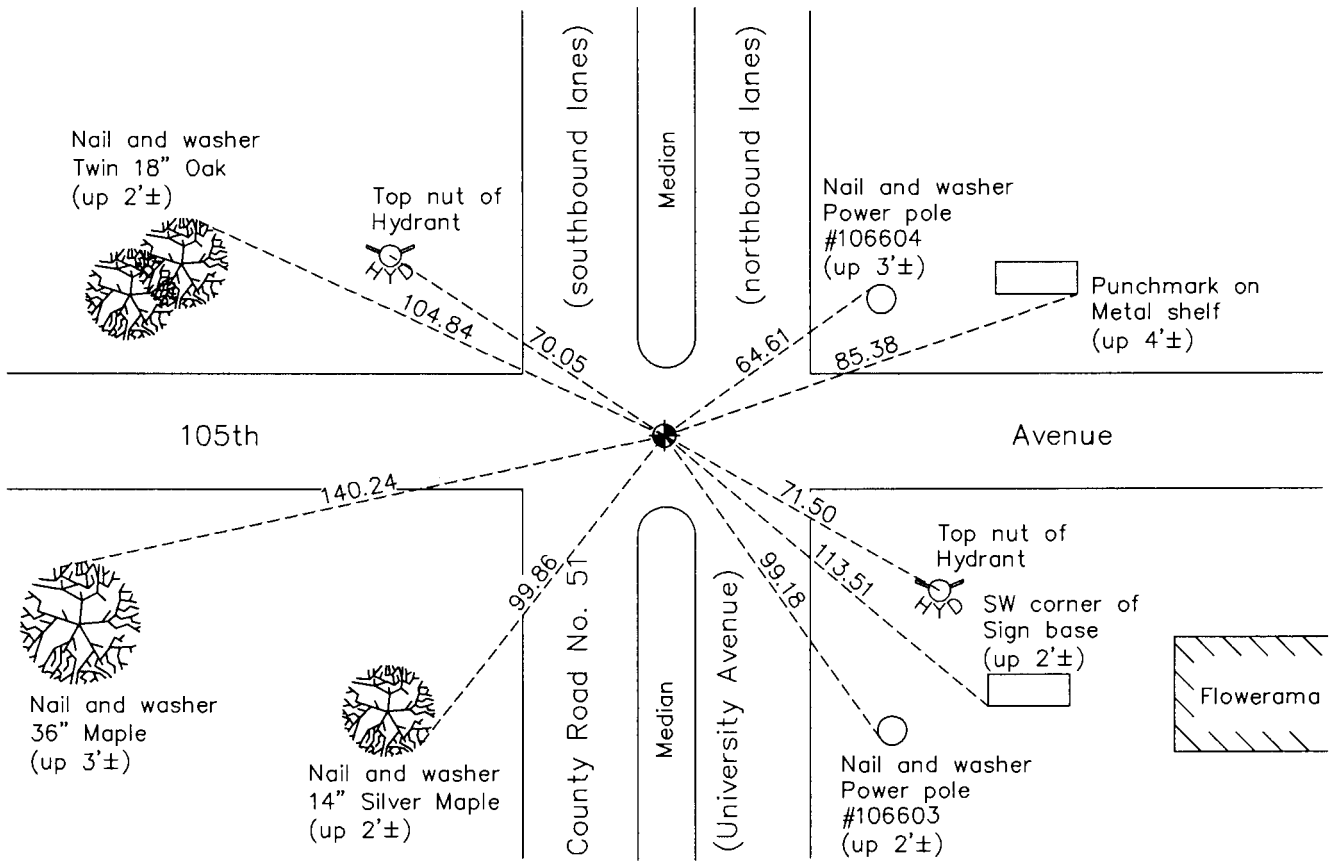

Revision Date
12/18/17

N.A.D. 1983 Coordinates
(1996 Adjustment)

County Project Coordinates	
Northing	<u>145767.9104</u>
Easting	<u>500067.4482</u>
Date	<u>6/11/98</u>

I hereby certify that this United States public land survey monument record is correct and complete to the best of my knowledge and belief.

Larry D. Hoium Date 12/18/17

Larry D. Hoium, Anoka County Surveyor

Minnesota License Number 18165

HISTORY OF GOVERNMENT CORNER

County of Anoka

State of Minnesota

East 1/4 Corner of Sec. 24 Township 31 Range 24

CORNER HISTORY:

June 1, 1945 - H.A. Cartwright found concrete monument. Established ties to monument.

September 1954 - Harold Wilke found concrete monument and updated ties.

July 1955 - Minder Engineering Company found concrete monument and updated ties.

Date unknown - Found concrete monument down 3' with an iron pipe centered over the monument and down 2". Replaced iron pipe with a cast iron monument set over the concrete monument. Updated ties.

June 26, 1964 - Found 1" iron pipe down 3" and the concrete monument down 37". Replaced iron pipe with a cast iron monument set flush with the surface over the concrete monument. Also set P.K. nails 2.00' north and east of monument. Updated ties.

July 11, 1966 - Found cast iron monument and updated ties.

July 19, 1967 - Found cast iron monument and updated ties.

July 16, 1974 - Found cast iron monument and updated ties.

June 23, 1977 - Found cast iron monument and updated ties.

July 8, 1980 - Found cast iron monument and updated ties.

February 14, 1992 - Found cast iron monument and updated ties.

September 19, 1994 - Set cast iron monument after road construction and updated ties.

June 11, 1998 - Found cast iron monument and established NAD 1983 (1996 Adjustment) Anoka County Project Coordinates by Static GPS methods.

December 15, 1998 - Found cast iron monument and updated ties.

March 22, 2010 - Found cast iron monument flush with the surface and updated ties.

May 26, 2015 - Found cast iron monument flush with the surface and updated ties.

May 17, 2017 - Set construction ties and removed cast iron monument prior to road construction. Verified location of corner by VRS GPS methods.

October 16, 2017 - Set cast iron monument after road construction using construction ties. Updated ties and verified location of corner by Static and VRS GPS methods.