

# CERTIFICATE OF LOCATION OF GOVERNMENT CORNER

County of Anoka

State of Minnesota



## North 1/4 Corner of Sec. 4 Township 32 Range 23

On the 10th day of August, 1962, the described corner was evidenced by a cast iron monument set by N.C. Hoium

and to perpetuate the location of said corner, at the exact location thereof, a permanent marker was placed consisting of a cast iron monument

AND on the 28th day of August, 2017, said permanent marker was replaced w/ 2" sq. steel Telespar mont. up 1'± w/ "Co. Surveyor" cap & punchmark. Updated ties & set sign & post 1' south.

Updated reference ties are as shown below.

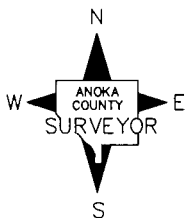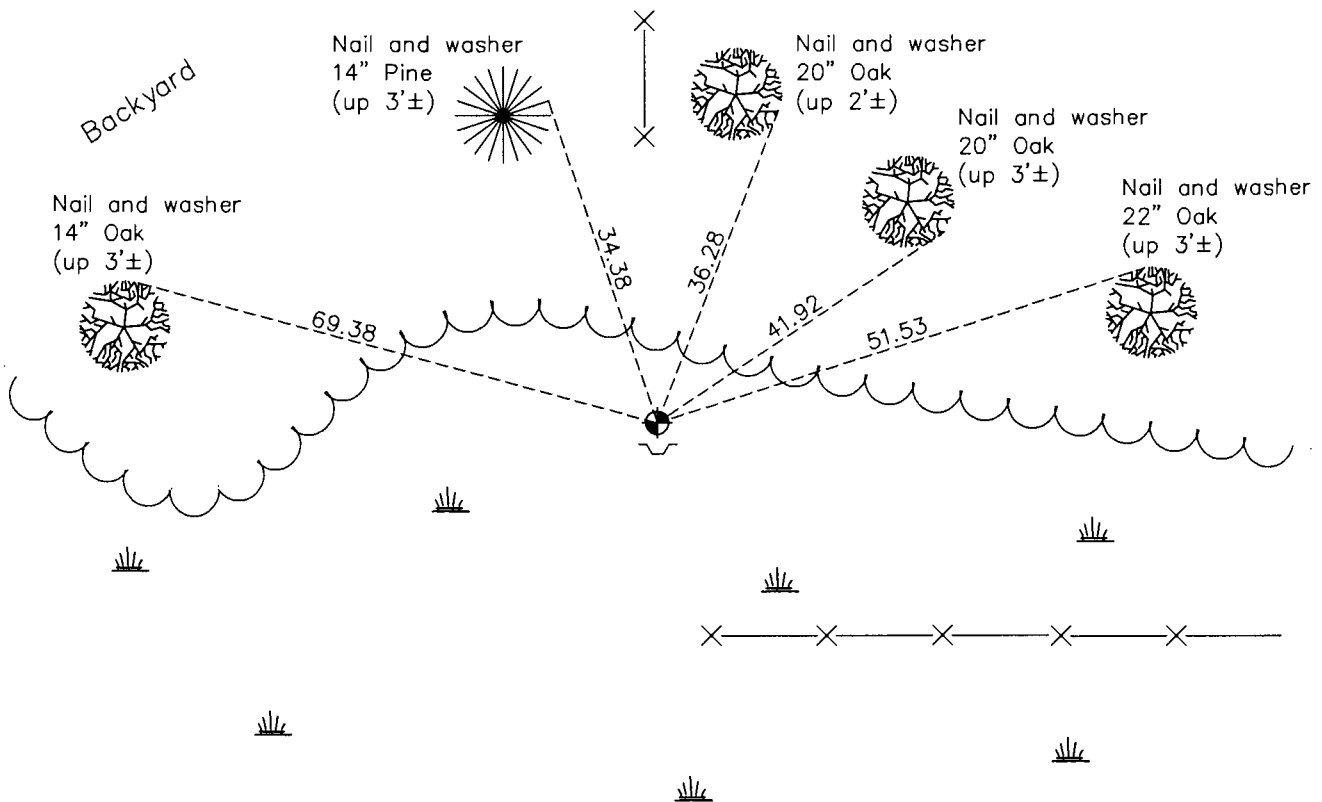

Revision Date  
12/22/17

N.A.D. 1983 Coordinates  
 (1996 Adjustment)

County Project Coordinates	
Northing	<u>195748.3056</u>
Easting	<u>513590.8237</u>
Date	<u>1/29/02</u>

I hereby certify that this United States public land survey monument record is correct and complete to the best of my knowledge and belief.

*Larry D. Hoium* Date 12/22/17

Larry D. Hoium, Anoka County Surveyor  
 Minnesota License Number 18165