

# CERTIFICATE OF LOCATION OF GOVERNMENT CORNER

County of Anoka

State of Minnesota



## West 1/4 Corner of Sec. 26 Township 32 Range 23

On the 23rd day of September, 1966, the described corner was evidenced by area resurvey

and to perpetuate the location of said corner, at the exact location thereof, a permanent marker was placed consisting of a cast iron monument

AND on the 26th day of June, 2017, said permanent marker was found broken. Replaced with a new cast iron monument set flush with the surface and updated ties.

Updated reference ties are as shown below.

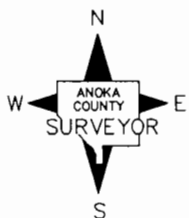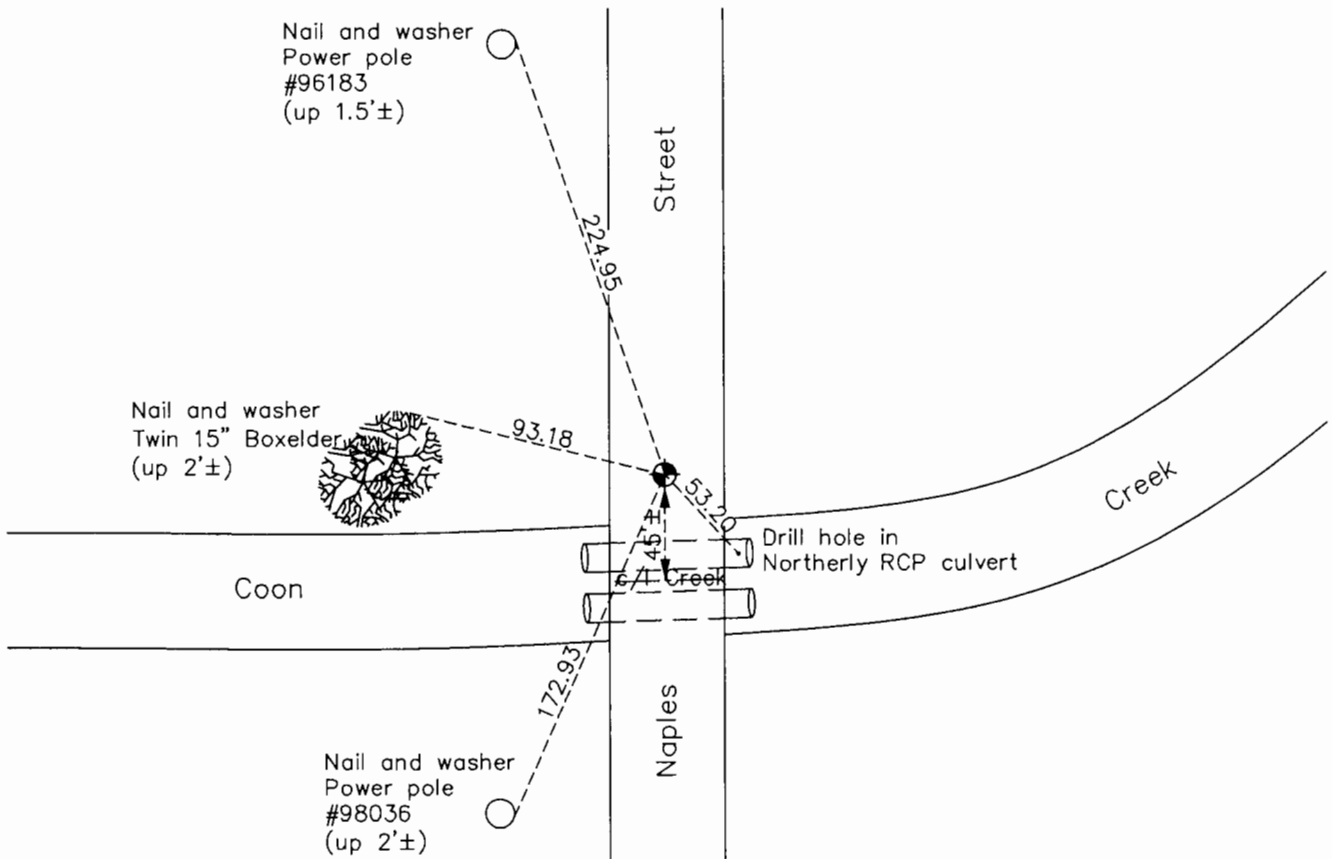

Revision Date

12/22/17

N.A.D. 1983 Coordinates  
(1996 Adjustment)

County Project Coordinates	
Northing	172108.6994
Easting	521463.9910
Date	11/30/01

I hereby certify that this United States public land survey monument record is correct and complete to the best of my knowledge and belief.

*Larry D. Hoium* Date 12/22/17

Larry D. Hoium, Anoka County Surveyor

Minnesota License Number 18165