

CERTIFICATE OF LOCATION OF GOVERNMENT CORNER

County of Anoka

State of Minnesota



South 1/4 Corner of Sec. 36 Township 31 Range 22

On the 16th day of May, 1963, the described corner was evidenced by a 1" iron pipe

and to perpetuate the location of said corner, at the exact location thereof, a permanent marker was placed consisting of a cast iron monument

AND on the 20th day of June, 2017, said permanent marker was found broken and leaning west. Replaced with a new cast iron monument. Updated ties on December 8, 2017.

Updated reference ties are as shown below.

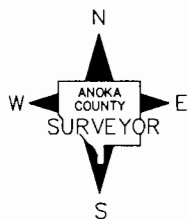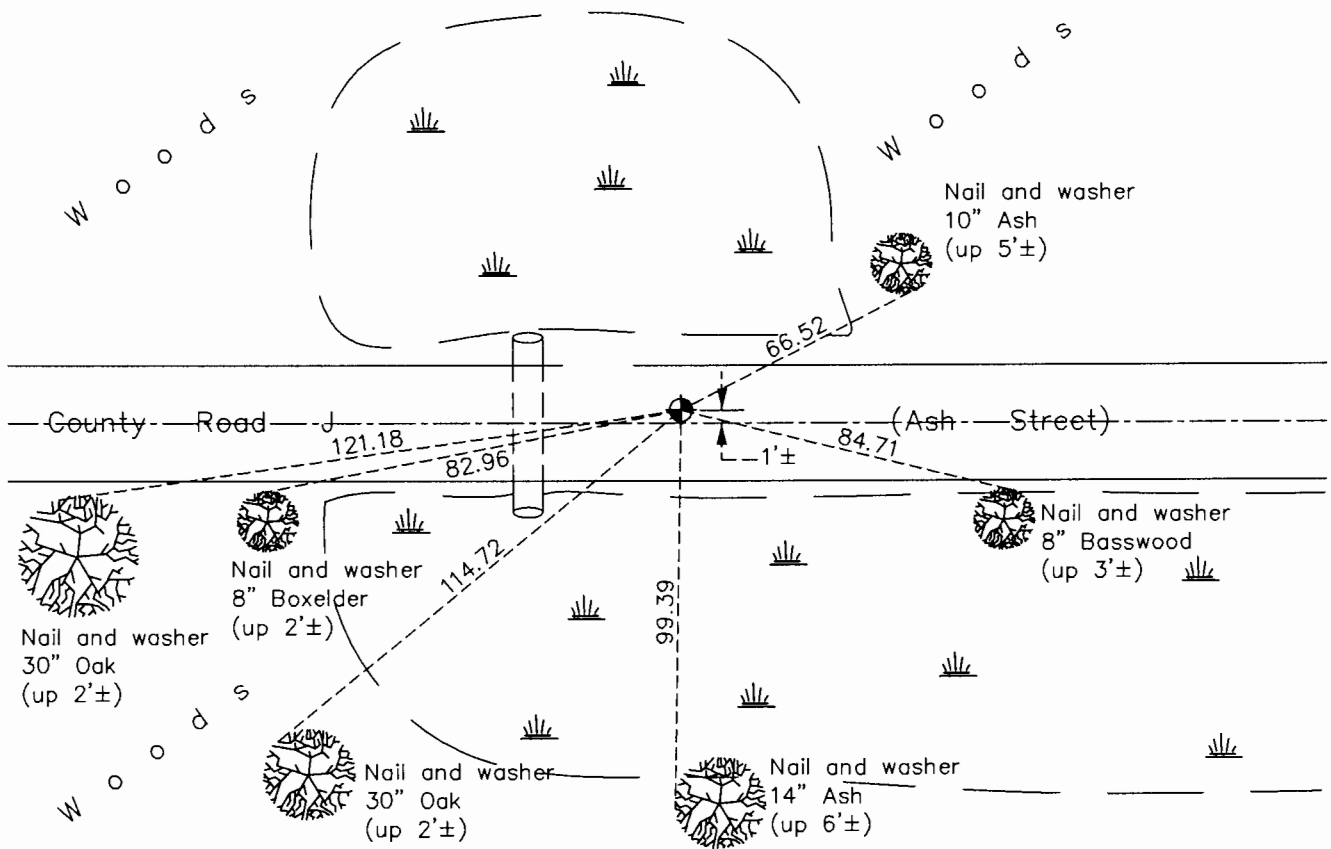

N.A.D. 1983 Coordinates
(1996 Adjustment)

County Project Coordinates	
Northing	<u>132394.5992</u>
Easting	<u>560936.6951</u>
Date	<u>4/06/98</u>

Revision Date
12/12/17

I hereby certify that this United States public land survey monument record is correct and complete to the best of my knowledge and belief.

Larry D. Hoium Date 12/13/17

Larry D. Hoium, Anoka County Surveyor

Minnesota License Number 18165

HISTORY OF GOVERNMENT CORNER

Page No. 140

County of Anoka

State of Minnesota

South 1/4 Corner of Sec. 36 Township 31 Range 22

CORNER HISTORY:

June 27, 1946 - Cartwright found monument, type unknown, and established ties to monument.

May 16, 1963 - Found 1" iron pipe down 0.1'± using Cartwright ties. Set nails and washers 2.00' north and east of iron pipe and updated ties.

June 30, 1965 - Found 1" iron pipe and updated ties.

September 25, 1969 - Replaced 1" iron pipe with a cast iron monument set flush with the surface. Set P.K. nails 2.00'± north and east of monument and updated ties.

July 16, 1973 - Found cast iron monument and updated ties.

June 7, 1977 - Found cast iron monument and updated ties.

August 14, 1980 - Found cast iron monument and updated ties.

July 9, 1986 - Found cast iron monument and updated ties.

June 4, 1990 - Updated ties and removed cast iron monument prior to road construction.

August 23, 1990 - Set cast iron monument flush with the surface after road construction using ties. Updated ties.

October 18, 1991 - Found cast iron monument and updated ties.

July 14, 1992 - Updated ties prior to road construction.

June 24, 1996 - Found cast iron monument and updated ties.

April 6, 1998 - Found cast iron monument and established NAD 1983 (1996 Adjustment) Anoka County Project Coordinates by Static GPS methods. Updated ties.

July 19, 2010 - Found cast iron monument and updated ties.

June 20, 2017 - Replaced broken cast iron monument, leaning west, with a new cast iron monument. Verified location of corner by Static and VRS GPS methods. Was unable to update ties until Winter.

December 8, 2017 - Found cast iron monument and updated ties.