

CERTIFICATE OF LOCATION OF GOVERNMENT CORNER

County of Anoka

State of Minnesota


Witness Corner of Sec. 6 Township 32 Range 24
(on north line of section east of Rum River)

On the 4th day of May, 1966, the described corner was evidenced by area resurvey

and to perpetuate the location of said corner, at the exact location thereof, a permanent marker was placed consisting of a cast iron monument

AND on the 21st day of July, 2023, said permanent marker was removed and replaced w/ 2" sq. steel telspar, set up 0.2'±, moved 10'± easterly to computed position. New ties established.

Updated reference ties are as shown below.

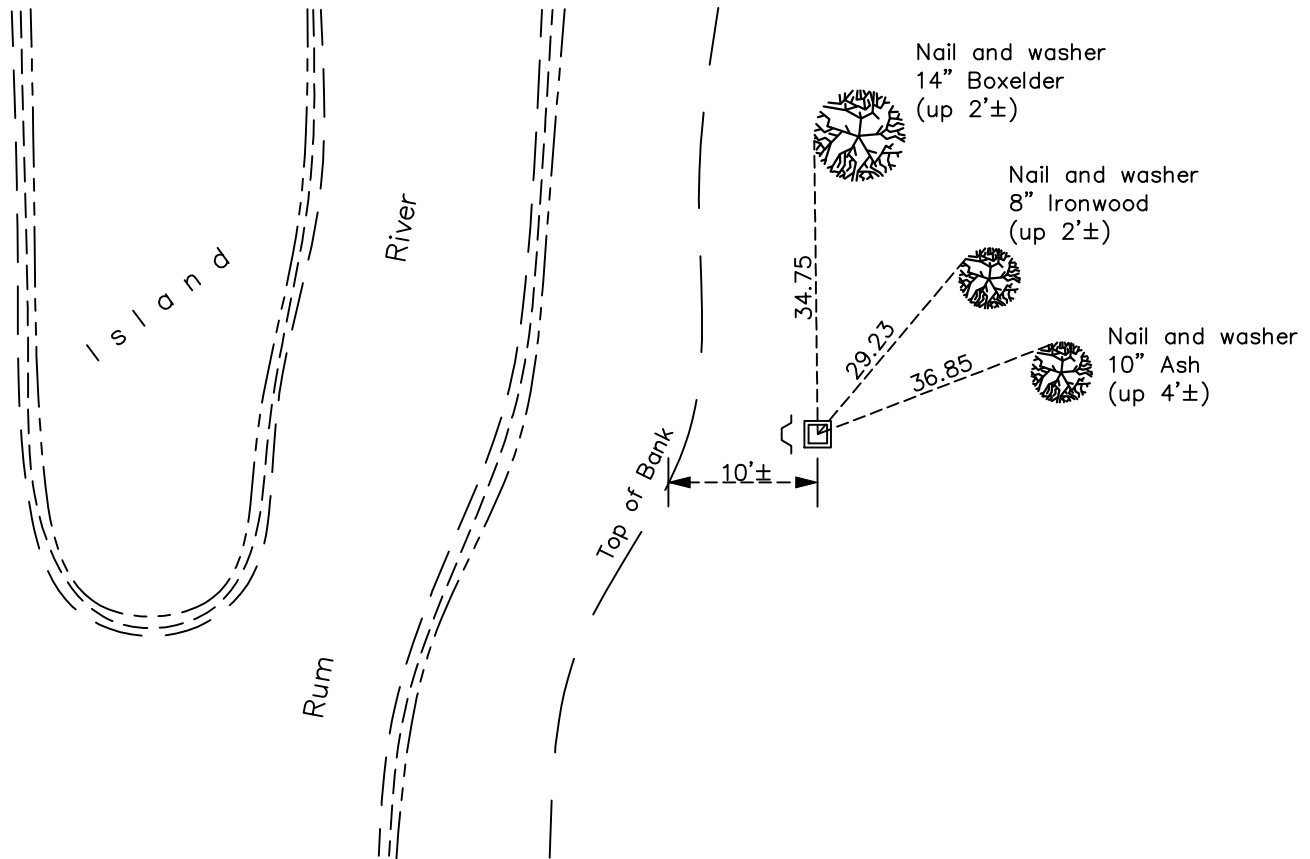

N
W ANOKA COUNTY SURVEYOR E
S

Revision Date
10/09/2023

N.A.D. 1983 Coordinates
(1996 Adjustment)

County Project Coordinates	
Northing	<u>196076.9797</u>
Easting	<u>471585.5735</u>
Date	<u>7/21/2023</u>

I hereby certify that this United States public land survey monument record is correct and complete to the best of my knowledge and belief.

David Zieglermeier Date 12/6/23

David M. Zieglermeier, Anoka County Surveyor
Minnesota License Number 46179

HISTORY OF GOVERNMENT CORNER

Page No. 9A

County of Anoka

State of Minnesota

Witness Corner of Sec. 6 Township 32 Range 24
(on north line of section east of Rum River)

CORNER HISTORY:

May 4, 1966 - Set cast iron monument down 0.2'± on north line of Section 6. Established face ties for approximate location purposes only. Landowner would not allow the use of nails and washers.

August 3, 1971 - Landowner would not allow us to access the corner.

5/31/84, 6/16/92 - Found cast iron monument and updated ties.

December 15, 2000 - Found cast iron monument and established NAD 1983 (1996 Adjustment) Anoka County Project Coordinates by Static GPS methods. Updated ties.

October 29, 2010 - Found cast iron monument down 1'± with a "T" fence post on north side of monument.

May 6, 2011 - Set sign and post on west side of cast iron monument.

8/2/16, 9/24/20, 6/9/23 - Found cast iron monument down 1'± with a "T" fence post on north side of monument and a sign and post on west side of cast iron monument. Updated ties.

July 21, 2023; Removed found cast iron monument. Replaced with 2" square steel telspar with aluminum cap and punch mark, set up 0.2'±. Previous postion N=196077.1771 E=471575.5754

Corner moved 10' Easterly along section line to a new position due to river bank erosion using ACS RTK GPS method. New ties established to shifted corner position. Sign and post added to West side.