

# CERTIFICATE OF LOCATION OF GOVERNMENT CORNER

County of Anoka

State of Minnesota


## North 1/4 Corner of Sec. 7 Township 32 Range 24

On the 8th day of July, 1968, the described corner was evidenced by an iron pipe

and to perpetuate the location of said corner, at the exact location thereof, a permanent marker was placed consisting of a cast iron monument

AND on the 25th day of January, 2023, said permanent marker was found flush with a sign and post on the North Side. Coordinates were updated using County RTK GPS method.

Updated reference ties are as shown below.

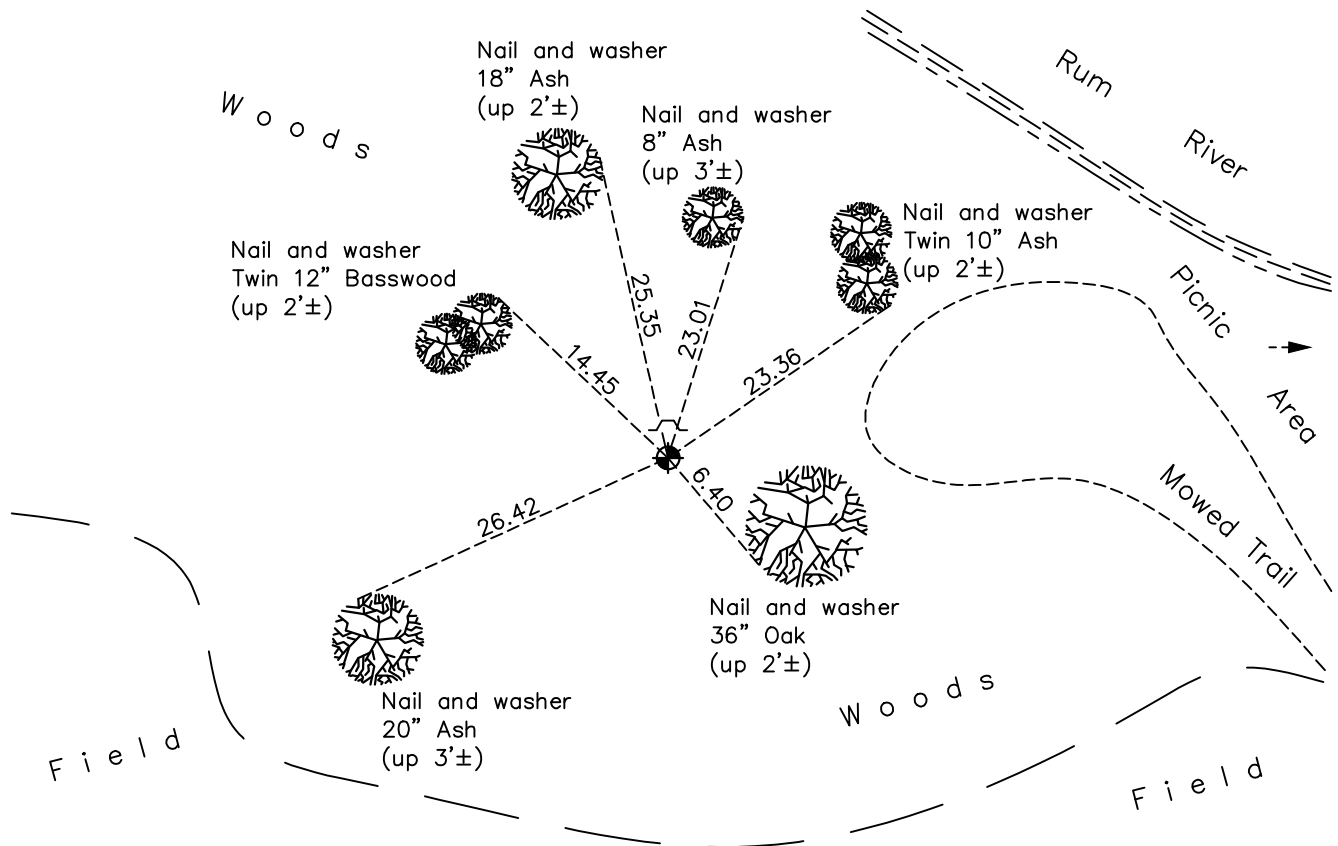

Revision Date

1/30/2023

N.A.D. 1983 Coordinates  
(2011 Adjustment)

County Project Coordinates	
Northing	<u>190902.376</u>
Easting	<u>471433.904</u>
Date	<u>1/25/2023</u>

I hereby certify that this United States public land survey monument record is correct and complete to the best of my knowledge and belief.

*David Zieglmeier* Date 3/1/23

David M. Zieglmeier, Anoka County Surveyor  
Minnesota License Number 46179

# HISTORY OF GOVERNMENT CORNER

Page No. 27

County of Anoka

State of Minnesota

## North 1/4 Corner of Sec. 7 Township 32 Range 24

### **CORNER HISTORY:**

July 28, 1960 – Found iron pipe up 0.6' in heavily wooded area as indicated on May 1958 Minnesota State Highway Department notes. Established ties to monument.

July 8, 1968 – Replaced iron pipe with a cast iron monument set flush with the surface. Updated ties.

June 29, 1972 – Found cast iron monument and updated ties.

May 26, 1976 – Found cast iron monument and updated ties.

May 31, 1979 – Found cast iron monument and updated ties.

July 7, 1982 – Found cast iron monument and updated ties.

June 13, 1985 – Found cast iron monument and updated ties.

August 17, 1988 – Found cast iron monument and updated ties. Sign and post shown on north side of monument, date set unknown.

August 6, 1993 – Found cast iron monument and updated ties.

December 15, 2000 – Found cast iron monument and established NAD 1983 (1996 Adjustment) Anoka County Project Coordinates by Static GPS methods. Updated ties.

October 25, 2010 – Found cast iron monument flush with the surface with sign and post on north side and updated ties.

July 1, 2016– Found cast iron monument flush with the surface and updated ties

October 7, 2020– Found cast iron monument flush with the surface and updated ties

January 25, 2023 – Found cast iron monument flush, position verified by County RTK GPS and the ties were reviewed. Position requires Coordinate update to 2011 adjustment. Previous Coordinates NAD 1983 (1996 adj) Northing 190902.5020; Easting 471433.8243