

# CERTIFICATE OF LOCATION OF GOVERNMENT CORNER

County of Anoka

State of Minnesota


## West 1/4 Corner of Sec. 9 Township 32 Range 24


On the 29th day of July, 1964, the described corner was evidenced by a 1/2" iron pipe set by N.C. Hoium

and to perpetuate the location of said corner, at the exact location thereof, a permanent marker was placed consisting of a cast iron monument

AND on the 13th day of October, 2020, said permanent marker was found flush with the surface and the ties were updated

Updated reference ties are as shown below.

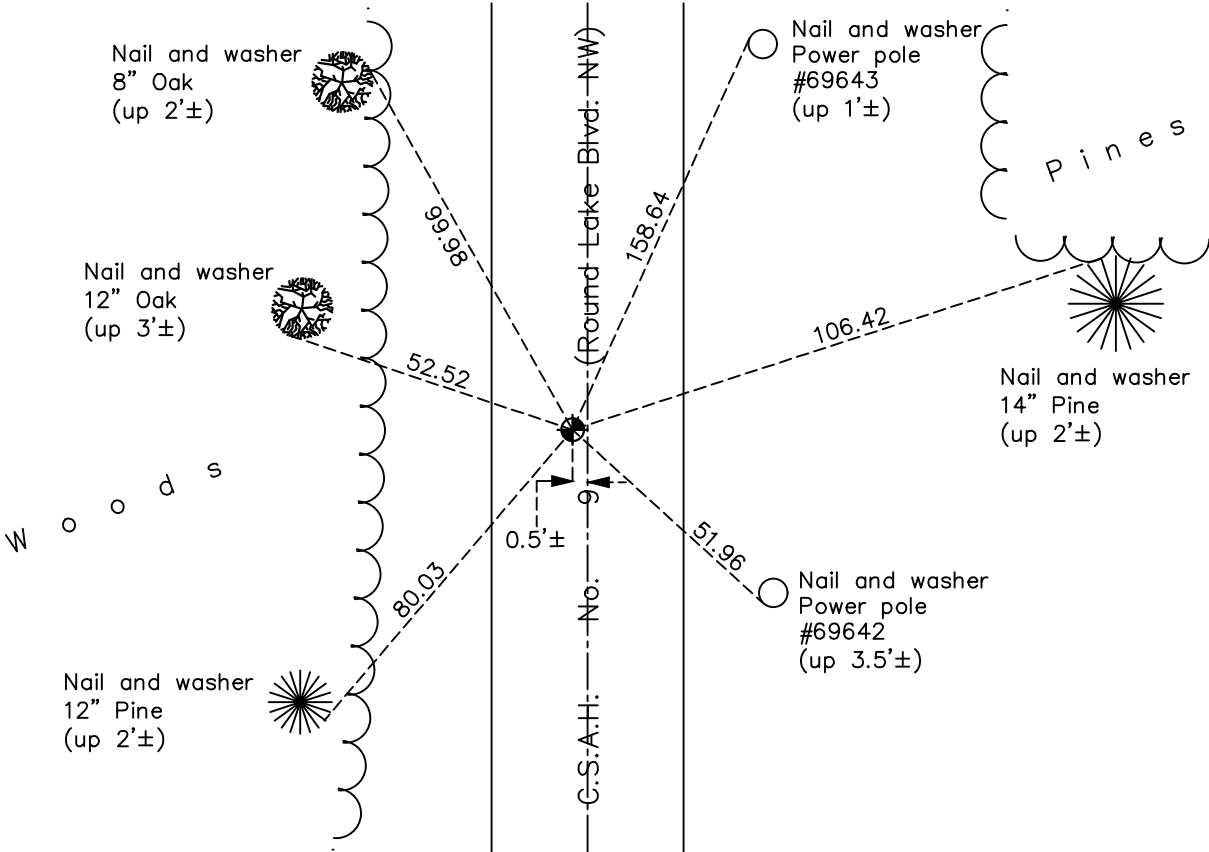

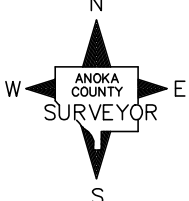N  
  
 S

Revision Date  
 01/14/21

N.A.D. 1983 Coordinates  
(1996 Adjustment)

County Project Coordinates	
Northing	188218.5120
Easting	479351.0887
Date	10/03/00

I hereby certify that this United States public land survey monument record is correct and complete to the best of my knowledge and belief.

*David M Zieglsmeier* Date 7/28/21

David M. Zieglsmeier, Anoka County Surveyor  
 Minnesota License Number 46179

# HISTORY OF GOVERNMENT CORNER

County of Anoka

State of Minnesota

## West 1/4 Corner of Sec. 9 Township 32 Range 24

### **CORNER HISTORY:**

May 19, 1964 – N.C. Hoium set a 1/2" iron pipe using a straight line and equal distance between the NW corner and the SW corner of Section 9.

July 29, 1964 – Found 1/2" iron pipe set by N.C. Hoium and flush with the surface and established ties to the iron pipe.

June 3, 1965 – Replaced 1/2" iron pipe with a cast iron monument and updated ties.

July 8, 1968 – Found cast iron monument and updated ties.

June 21, 1972 – Found cast iron monument and set P.K. nails north and east of monument. Updated ties.

May 27, 1976 – Found cast iron monument and updated ties.

May 31, 1979 – Found cast iron monument and updated ties.

September 3, 1982 – Found cast iron monument and updated ties.

May 29, 1985 – Found cast iron monument and updated ties.

August 9, 1988 – Found cast iron monument and updated ties.

July 15, 1993 – Found cast iron monument and updated ties.

October 3, 2000 – Found cast iron monument and established NAD 1983 (1996 Adjustment) Anoka County Project Coordinates by Static GPS methods. Updated ties.

July 18, 2001 – Set construction ties and removed cast iron monument prior to road construction.

February 15, 2011 – Found cast iron monument and updated ties.

January 26, 2016 – Found cast iron monument flush with the surface and 0.5'± west of the centerline. Updated ties.

October 13, 2020 – Found cast iron monument flush with the surface and 0.5'± west of the centerline. Updated ties.