

CERTIFICATE OF LOCATION OF GOVERNMENT CORNER

County of Anoka

State of Minnesota



South 1/4 Corner of Sec. 11 Township 32 Range 24

On the 1st day of June, 1962, the described corner was evidenced by a 1/2" iron pipe in a wooden post

and to perpetuate the location of said corner, at the exact location thereof, a permanent marker was placed consisting of a red and white 2" square steel telespar monument set up 1'± with a sign and post set on west side

AND on the 16th day of November, 2020, said permanent marker was found w/ red & white 2" sq steel Telespar w/ "Co. Surveyor" cap up 1'±. Sign & post set on south side.

Updated reference ties are as shown below.

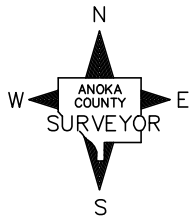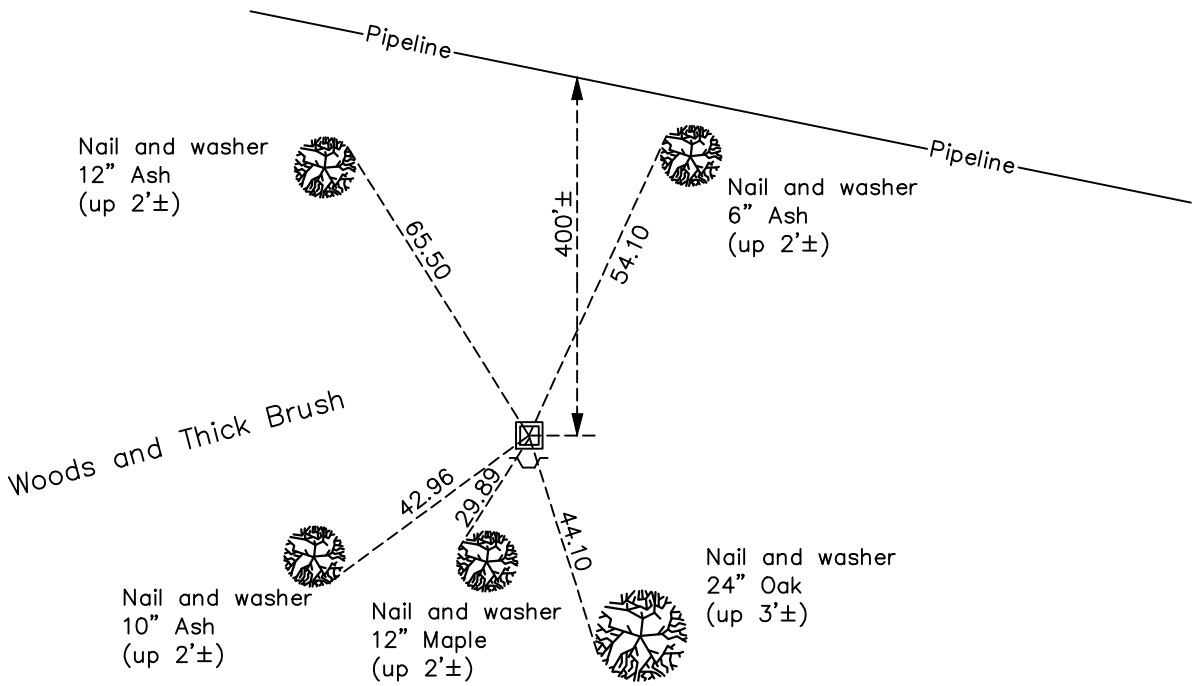

Revision Date
 01/22/21

N.A.D. 1983 Coordinates
 (1996 Adjustment)

| County Project Coordinates | |
|----------------------------|-------------|
| Northing | 185462.0639 |
| Easting | 492527.2769 |
| Date | 11/06/01 |

I hereby certify that this United States public land survey monument record is correct and complete to the best of my knowledge and belief.
David M Zieglmeier Date 7/28/21
 David M. Zieglmeier, Anoka County Surveyor
 Minnesota License Number 46179

HISTORY OF GOVERNMENT CORNER

Page No. 40

County of Anoka

State of Minnesota

South 1/4 Corner of Sec. 11 Township 32 Range 24

CORNER HISTORY:

June 1, 1962 – Found 1/2” iron pipe set in old wood post in swamp and set a red and white iron pipe up 3’ over iron. Established ties to monument.

August 17, 1964 – Found red and white iron pipe and updated ties.

July 12, 1968 – Found red and white iron pipe and updated ties.

June 21, 1972 – Found red and white iron pipe and updated ties.

May 27, 1976 – Found red and white iron pipe and updated ties.

June 1, 1979 – Found red and white iron pipe and updated ties.

June 29, 1982 – Found red and white iron pipe and updated ties.

March 15, 1983 – Replaced red and white iron pipe with a new red and white iron pipe and updated ties.

August 17, 1988 – Found red and white iron pipe and updated ties.

November 6, 2001 – Found red and white iron pipe and established NAD 1983 (1996 Adjustment) Anoka County Project Coordinates by Static GPS methods.

January 26, 2011 – Found red and white iron pipe leaning southwesterly approximately 0.5’ and updated ties.

March 14, 2011 – Replaced leaning red and white iron pipe with a 2” square steel Telspar monument set up 1’± with a “County Surveyor” cap and punchmark at corner location. Verified position by VRS GPS methods.
Also set sign and post on west side of monument

January 14, 2016 – Found Telspar off from ties and leaning. Found two ties and set 1/2” Iron Pipe with cap. Verified position by static GPS methods.

February 3, 2016 – Removed Telspar and Set new 2”X 6’ Red and white square steel Telspar monument with “County Surveyor” cap. Sign and post was set on South side. Updated ties.

November 16, 2020 – Found red and white iron pipe with Co. Surveyor cap and updated ties.