

CERTIFICATE OF LOCATION OF GOVERNMENT CORNER

County of Anoka

State of Minnesota



Southwest Corner of Sec. 13 Township 32 Range 24

On the 1st day of August, 1960, the described corner was evidenced by an iron pipe set by N.C. Hoium

and to perpetuate the location of said corner, at the exact location thereof, a permanent marker was placed consisting of a cast iron monument

AND on the 16th day of October, 2020, said permanent marker was found and the ties were updated

Updated reference ties are as shown below.

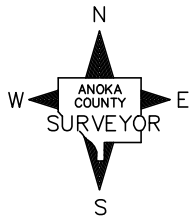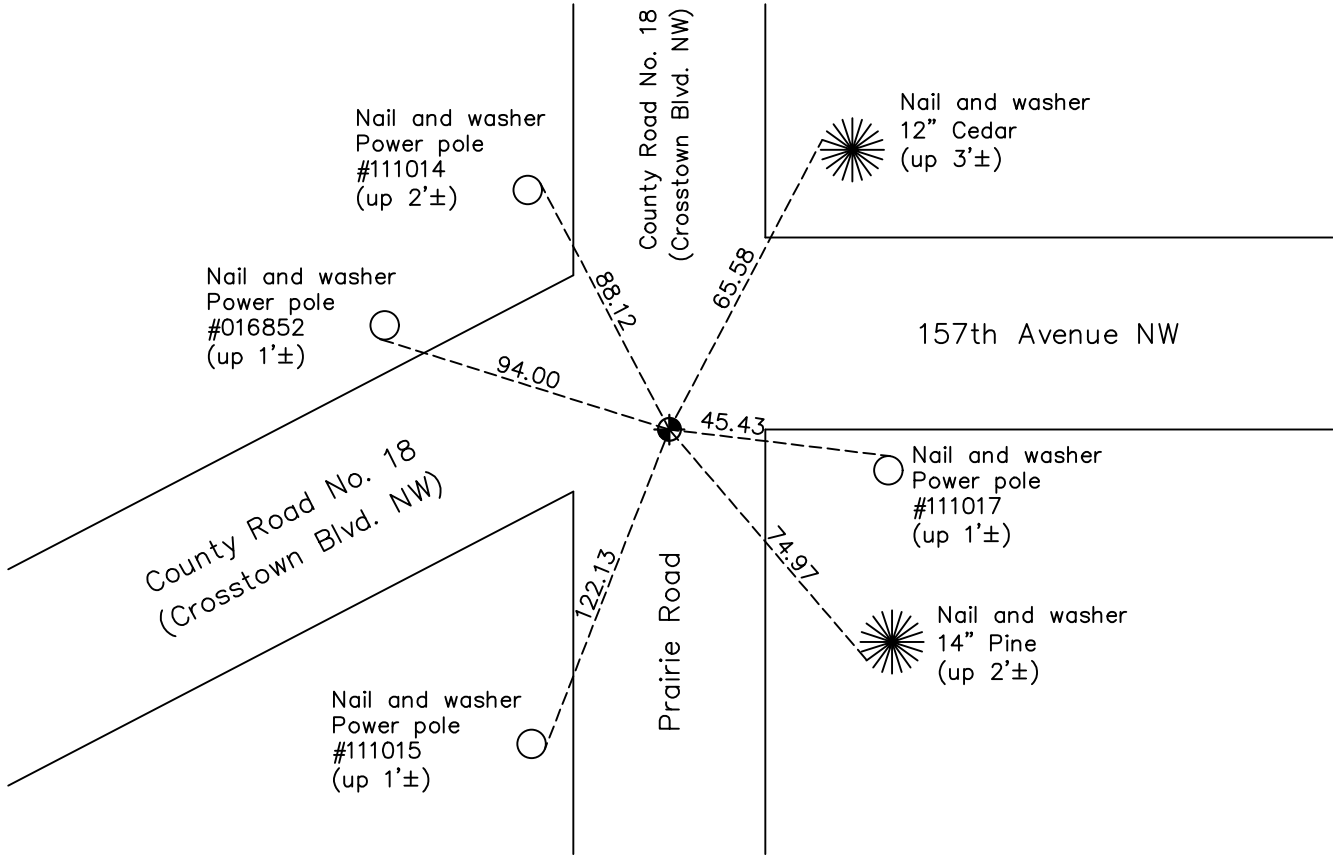

Revision Date
 01/29/21

N.A.D. 1983 Coordinates
 (1996 Adjustment)

County Project Coordinates	
Northing	180107.4416
Easting	495135.4782
Date	10/02/00

I hereby certify that this United States public land survey monument record is correct and complete to the best of my knowledge and belief.
David M Zieglmeier Date 7/28/21
 David M. Zieglmeier, Anoka County Surveyor
 Minnesota License Number 46179

HISTORY OF GOVERNMENT CORNER

County of Anoka

State of Minnesota

Southwest Corner of Sec. 13 Township 32 Range 24

CORNER HISTORY:

August 1, 1960 - Found iron pipe set by N.C. Hoium down 0.8'± and established ties to iron.

August 17, 1964 - Found iron pipe and updated ties.

July 12, 1968 - Replaced iron pipe with a cast iron monument. Updated ties.

June 22, 1972 - Found cast iron monument and updated ties.

June 2, 1976 - Found cast iron monument and updated ties.

June 28, 1978 - Replaced solid cast iron monument with extendable cast iron monument flush. Updated ties.

June 4, 1979 - Found cast iron monument and updated ties.

June 24, 1982 - Found cast iron monument and updated ties.

June 3, 1985 - Found cast iron monument and updated ties.

August 2, 1988 - Found cast iron monument and updated ties.

July 22, 1993 - Found cast iron monument and updated ties.

October 2, 2000 - Found cast iron monument and updated ties. Established NAD 1983 (1996 adj.) Anoka County project coordinates by static GPS methods.

June 27, 2006 - Set construction ties and removed cast iron monument prior to road construction. Updated ties. Date reset unclear.

January 27, 2011 - Found cast iron monument and updated ties.

January 27, 2016 - Found cast iron monument and updated ties.

August 3, 2018 - Found cast iron monument and updated ties. Removed cast iron monument prior to road construction.

October 31, 2018 - Set cast iron monument flush after road construction, verified position by static GPS methods and updated ties.

October 16, 2020 - Found cast iron monument and updated ties.