

# CERTIFICATE OF LOCATION OF GOVERNMENT CORNER

County of Anoka

State of Minnesota


## North 1/4 Corner of Sec. 21 Township 32 Range 24

On the 31st day of May, 1979, the described corner was evidenced by area resurvey

and to perpetuate the location of said corner, at the exact location thereof, a permanent marker was placed consisting of a cast iron monument with a sign and post on the north side.

AND on the 16th day of November, 2020, said permanent marker was found down 0.5'± and the ties were updated.

Updated reference ties are as shown below.

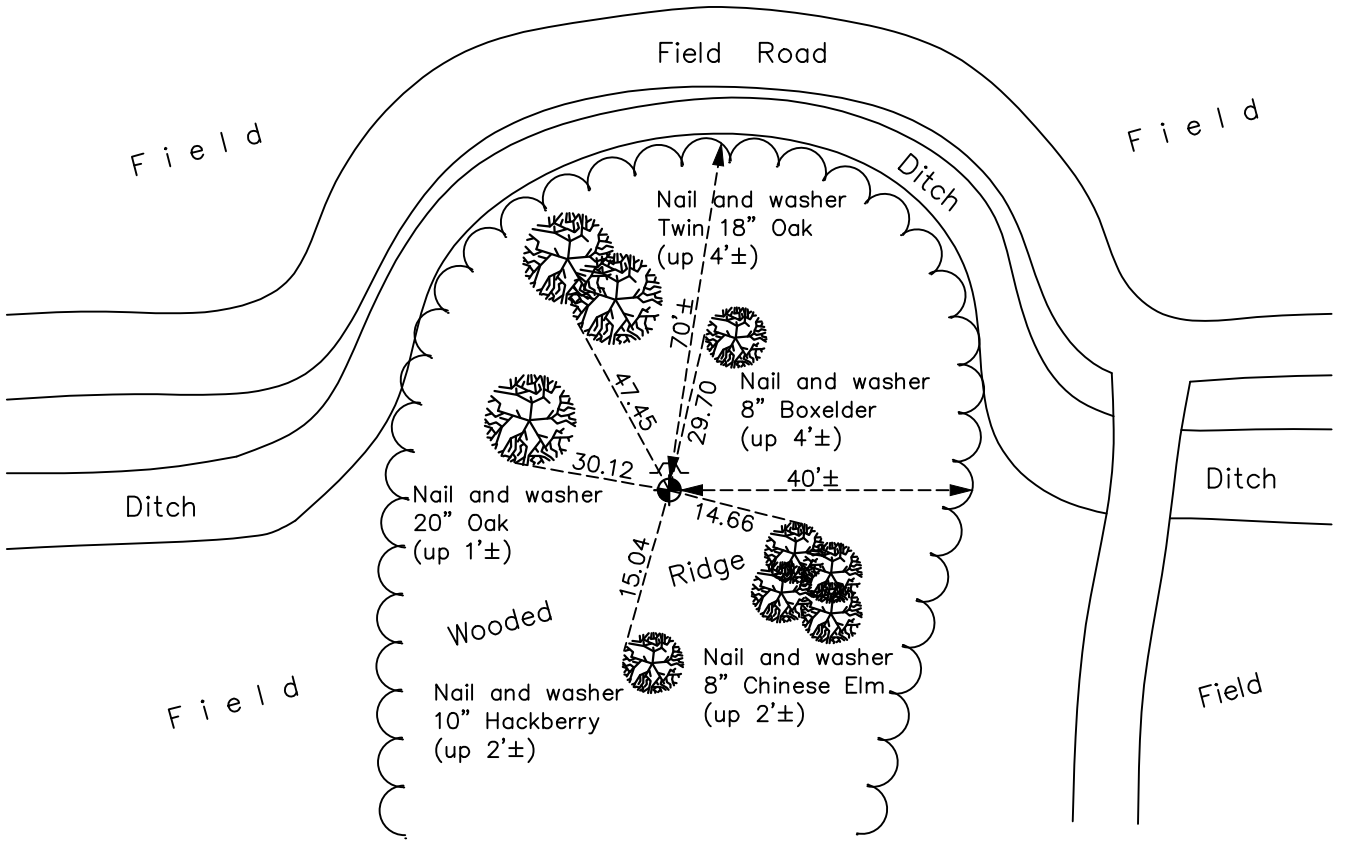

Revision Date

01/29/21

N.A.D. 1983 Coordinates  
(1996 Adjustment)

County Project Coordinates	
Northing	180357.7941
Easting	482031.7027
Date	2/13/01

I hereby certify that this United States public land survey monument record is correct and complete to the best of my knowledge and belief.

*David M Zieglsmeier* Date 7/28/21

David M. Zieglsmeier, Anoka County Surveyor  
Minnesota License Number 46179

# HISTORY OF GOVERNMENT CORNER

Page No. 63A

County of Anoka

State of Minnesota

## North 1/4 Corner of Sec. 21 Township 32 Range 24

### **CORNER HISTORY:**

May 31, 1979 – Set cast iron monument flush with surface using area resurvey and established ties to monument. Set sign and post on north side of monument.

July 7, 1983 – Found cast iron monument and updated ties.

August 12, 1988 – Replaced cast iron monument with a new cast iron monument and updated ties.

August 2, 1993 – Found cast iron monument and updated ties.

February 13, 2001 – Found cast iron monument and established NAD 1983 (1996 Adjustment) Anoka County Project Coordinates by Static GPS methods. Updated ties.

November 4, 2010 – Found cast iron monument down  $0.5' \pm$  with a sign and post on north side and updated ties.

July 18, 2016 – Found cast iron monument down  $0.5' \pm$  with a sign and post on north side and updated ties.

November 16, 2020 – Found cast iron monument down  $0.5' \pm$  with a sign and post on north side and updated ties.