

CERTIFICATE OF LOCATION OF GOVERNMENT CORNER

County of Anoka

State of Minnesota


Witness Corner of Sec. 33 Township 32 Range 24
(on west line of NW 1/4)

On the 10th day of July, 1990, the described corner was evidenced by area resurvey

and to perpetuate the location of said corner, at the exact location thereof, a permanent marker was placed consisting of a cast iron monument

AND on the 13th day of October, 2020, said permanent marker was found flush with the
surface and the ties were updated

Updated reference ties are as shown below.

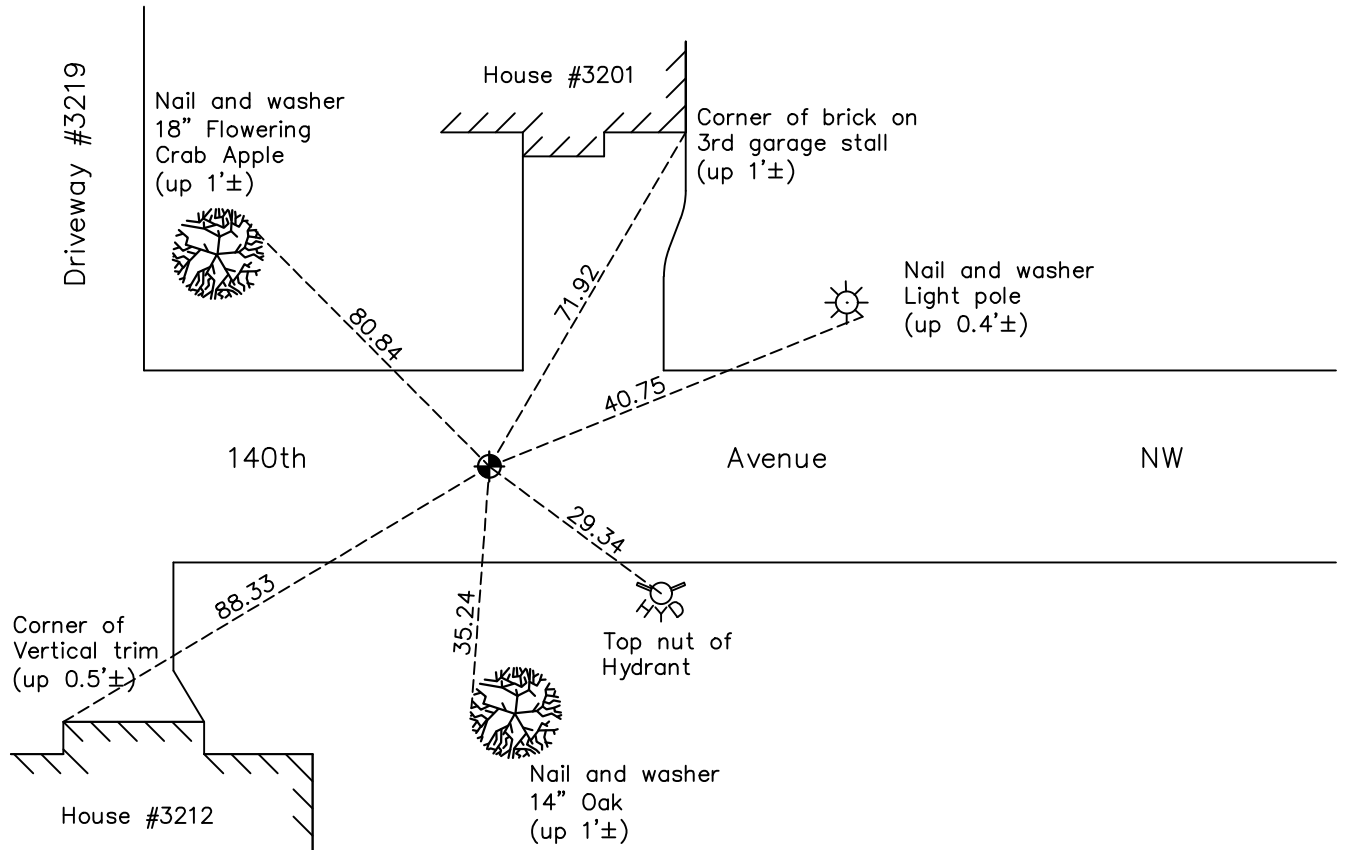

Revision Date
02/16/21

N.A.D. 1983 Coordinates
 (1996 Adjustment)

County Project Coordinates	
Northing	<u>169142.8031</u>
Easting	<u>479251.1922</u>
Date	<u>10/26/00</u>

I hereby certify that this United States public land survey monument record is correct and complete to the best of my knowledge and belief.
David M Zieglmeier Date 8/2/21
David M. Zieglmeier, Anoka County Surveyor
 Minnesota License Number 46179