

# CERTIFICATE OF LOCATION OF GOVERNMENT CORNER

County of Anoka

State of Minnesota



## East 1/4 Corner of Sec. 31 Township 32 Range 24

On the \_\_\_\_ day of July, 1956, the described corner was evidenced by a 1" iron pipe  
in an old rotted post

and to perpetuate the location of said corner, at the exact location thereof, a permanent marker  
was placed consisting of a red and white iron pipe

AND on the 19th day of January, 2021, said permanent marker was found up 5'± and the  
ties were updated

Updated reference ties are as shown below.

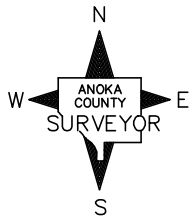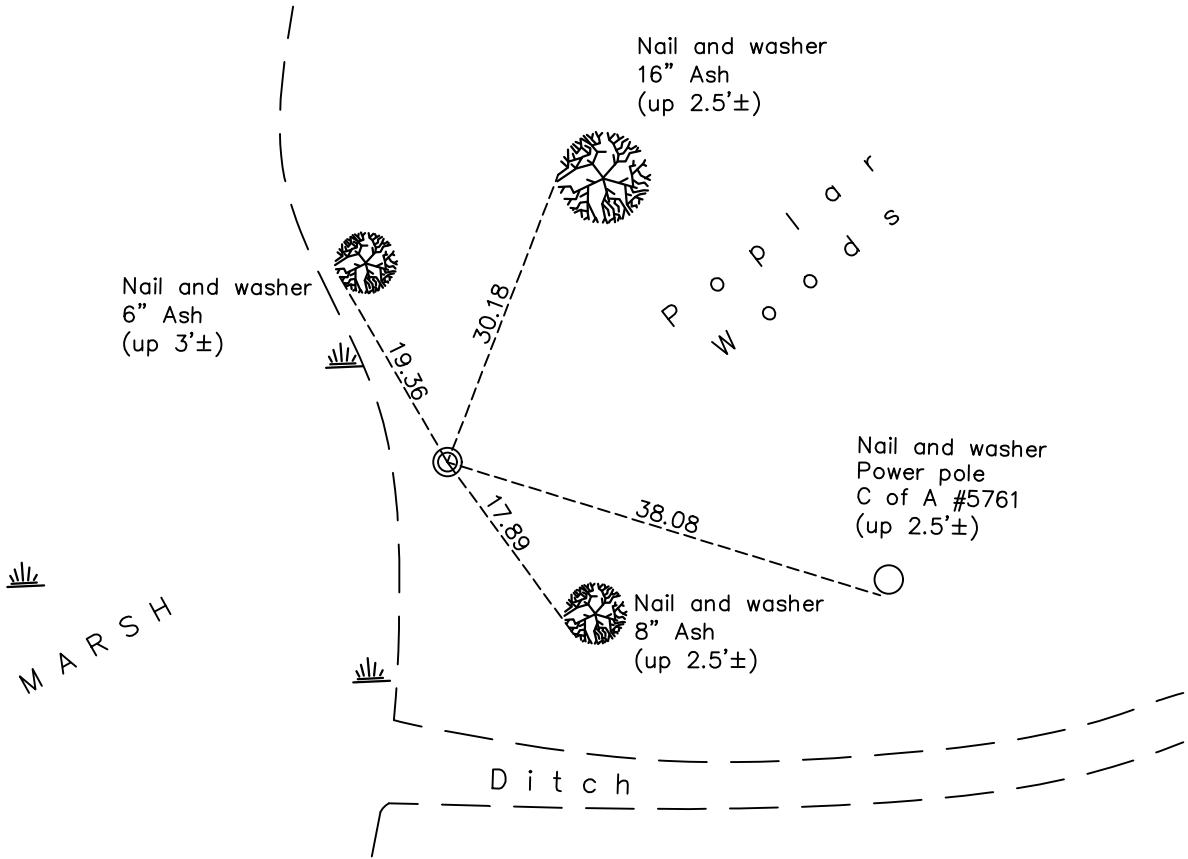

Revision Date

01/19/21

N.A.D. 1983 Coordinates  
(1996 Adjustment)

County Project Coordinates	
Northing	<u>167216.4311</u>
Easting	<u>473978.7559</u>
Date	<u>12/01/00</u>

I hereby certify that this United States public land survey monument record is correct and complete to the best of my knowledge and belief.

David M Zieglmeier Date 8/2/21

David M. Zieglmeier, Anoka County Surveyor

Minnesota License Number 46179

# HISTORY OF GOVERNMENT CORNER

Page No. 112

County of Anoka

State of Minnesota

## East 1/4 Corner of Sec. 31 Township 32 Range 24

### **CORNER HISTORY:**

July 1956 – Willard Lundstrom found an old rotten wood post below the surface. The position of the post agreed with lines of occupation in the SE 1/4.

August 2, 1956 – W. Lundstrom set 3/4" iron pipe in center of wood post.

December 9, 1964 – Replaced 3/4" iron pipe with a 1" X 10' red and white iron pipe set 4'± above the surface. Updated ties.

July 25, 1968 – Found red and white iron pipe and updated ties.

July 1974 – A section resurvey was performed. It was found that the position of the iron pipe agreed with the position set by W. Lundstrom (see field notes).

January 26, 1978 – Found red and white iron pipe up 3'± and updated ties.

June 12, 1979 – Found red and white iron pipe and updated ties.

June 13, 1985 – Found red and white iron pipe and updated ties.

August 19, 1988 – Found red and white iron pipe and updated ties.

December 1, 2000 – Found red and white iron pipe and established NAD 1983 (1996 Adjustment) Anoka County Project Coordinates by Static GPS methods. Updated ties.

December 09, 2010 – Found 2" red and white iron pipe up 4'± and updated ties.

March 3, 2016 – Found red and white iron pipe up 5'± and updated ties.

January 19, 2021 – Found red and white iron pipe up 5'± and updated ties.