

CERTIFICATE OF LOCATION OF GOVERNMENT CORNER

County of Anoka

State of Minnesota



East 1/4 Corner of Sec. 33 Township 32 Range 24

On the 29th day of August, 1960, the described corner was evidenced by a 1" iron pipe

and to perpetuate the location of said corner, at the exact location thereof, a permanent marker was placed consisting of a cast iron monument

AND on the 16th day of November, 2020, said permanent marker was found down 0.1'± and the ties were updated

Updated reference ties are as shown below.

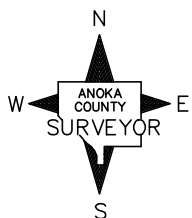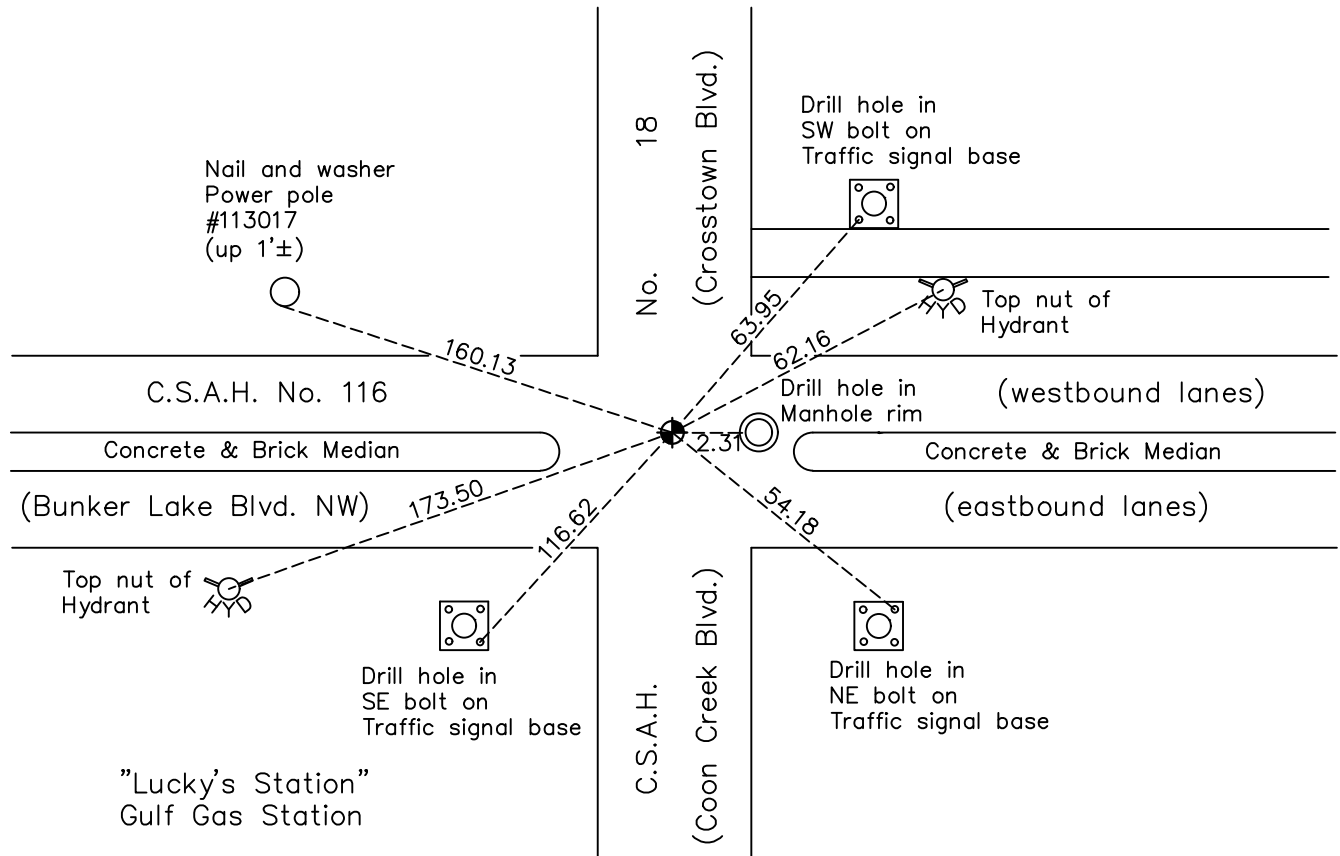

N.A.D. 1983 Coordinates
(1996 Adjustment)

County Project Coordinates	
Northing	167219.2927
Easting	484482.4921
Date	7/19/00

Revision Date
03/18/2021

I hereby certify that this United States public land survey monument record is correct and complete to the best of my knowledge and belief.
David M Zieglermeier Date 8/2/21
 David M. Zieglermeier, Anoka County Surveyor
 Minnesota License Number 46179