

# CERTIFICATE OF LOCATION OF GOVERNMENT CORNER

County of Anoka

State of Minnesota

## North 1/16 Corner of Sec. 36 Township 32 Range 24

Of The Southeast Quarter



I hereby certify that on the 23rd day of March, 1973, I found the described corner which was evidenced by area resurvey

and I further certify that to perpetuate the location of said corner, I did, at the exact location thereof, place a permanent marker consisting of a cast iron monument

which reference or witness monuments are located in the manner following:

Comp DZ  
N=165,621  
E=500,228

±5'

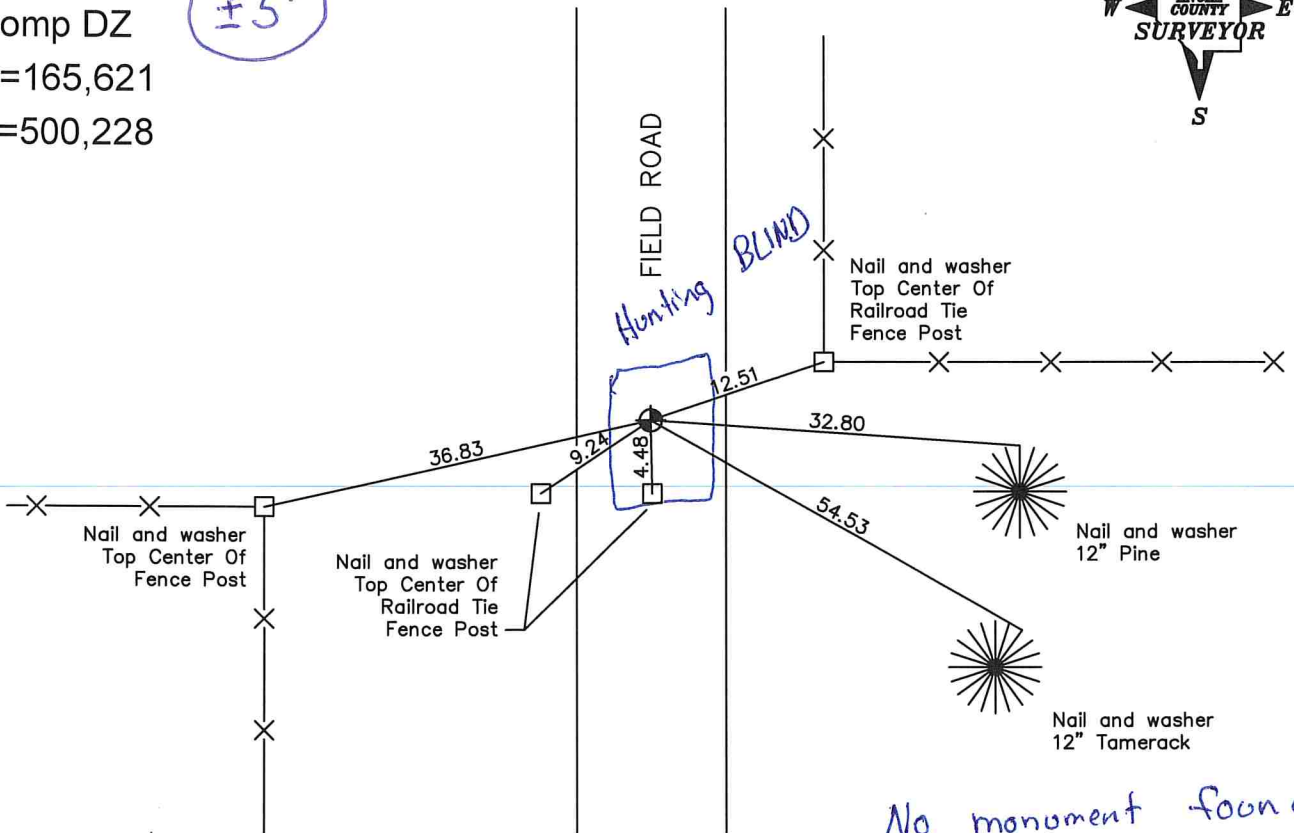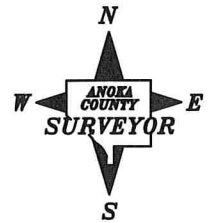

No monument found  
All ties destroyed AV/DD  
4/10/23

Revised date

7/6/82
6/17/85
8/4/88

N.A.D. 1983 Co-ordinates

County Project Co-ordinates	
Northing	_____
Easting	_____

State Plane Co-ordinates	
Y	_____
X	_____

Date (No GPS Info Taken)