

# CERTIFICATE OF LOCATION OF GOVERNMENT CORNER

County of Anoka

State of Minnesota


South 1/16 Corner of Sec. 11 Township 32 Range 24

North-South 1/4 Line

I hereby certify that on the 16th day of October, 1961, I found the described corner which was evidenced by a sandstone rock

and I further certify that to perpetuate the location of said corner, I did, at the exact location thereof, place a permanent marker consisting of a sandstone rock

which reference or witness monuments are located in the manner following:

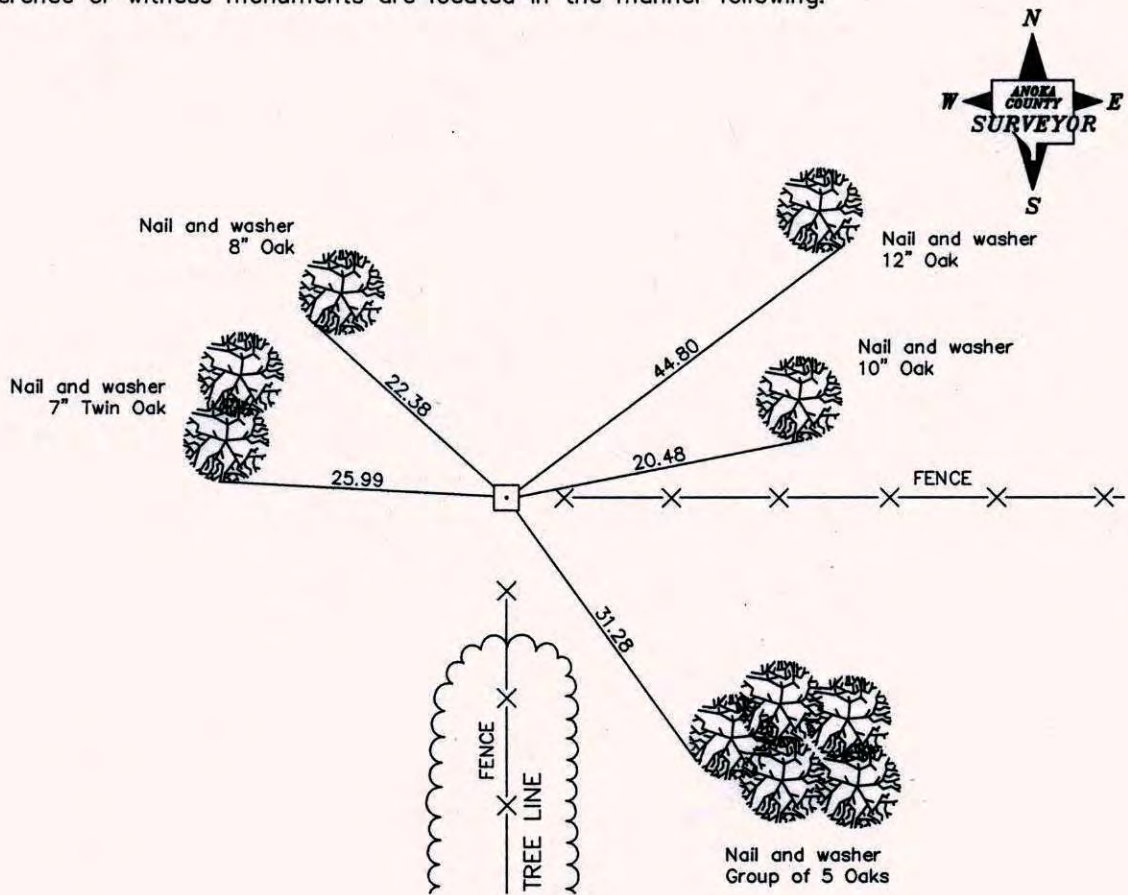

Revised date

6/17/82

N.A.D. 1983 Co-ordinates

County Project Co-ordinates	State Plane Co-ordinates
Northing _____	Y _____
Easting _____	X _____

Date(No GPS Info Taken)



# CERTIFICATE OF LOCATION OF GOVERNMENT CORNER


County of Anoka State of Minnesota

S. 16<sup>TH</sup> Corner of Sec. 11 Township 32 Range 24  
N.S. QTR. LINE


I hereby certify that on the 16 day of OCT., 1961, I found the described corner which was evidenced by SANDSTONE ROCK

and I further certify that to perpetuate the location of said corner, I did, at the exact location thereof, place a permanent marker consisting of SAME

which reference or witness monuments are located in the manner following:

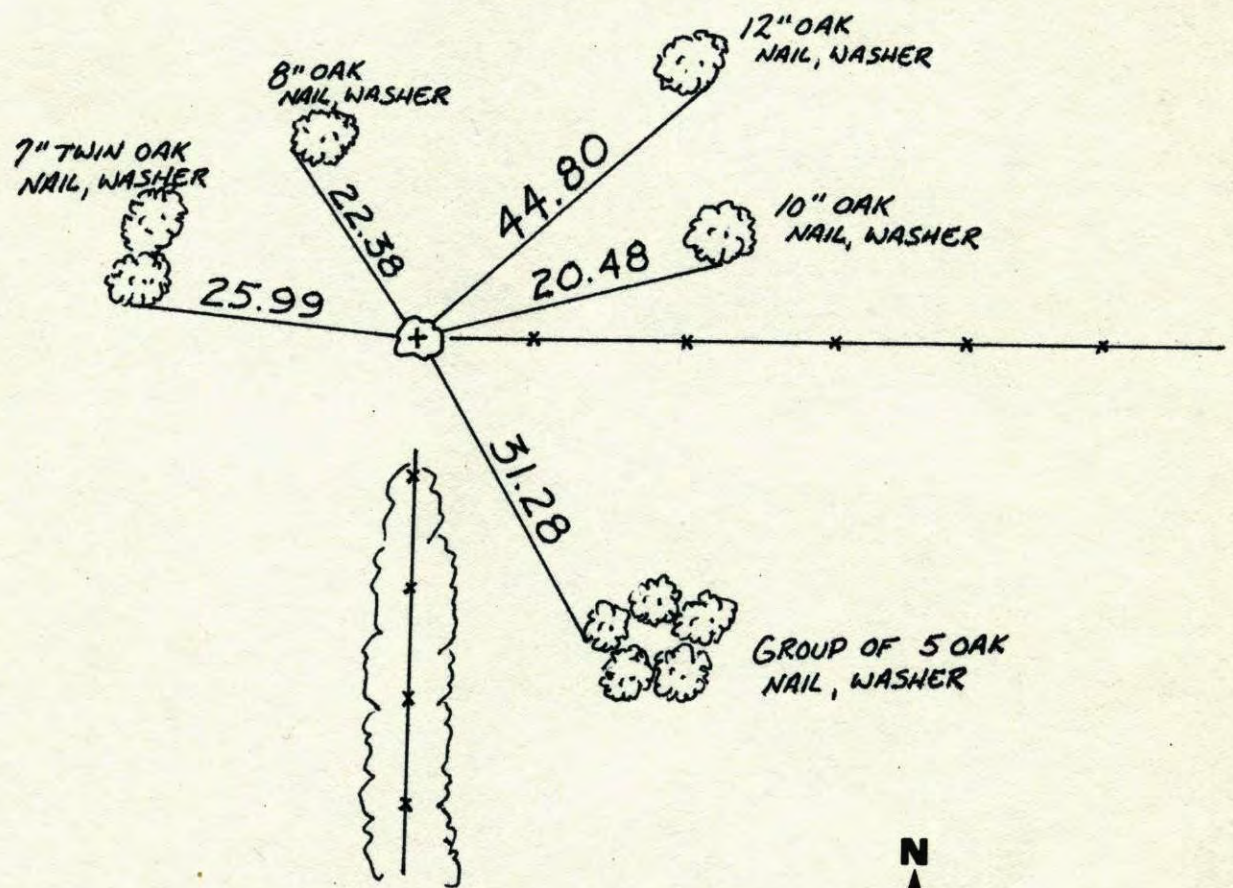


Revised date	Revised date	Revised date
6-17-82		

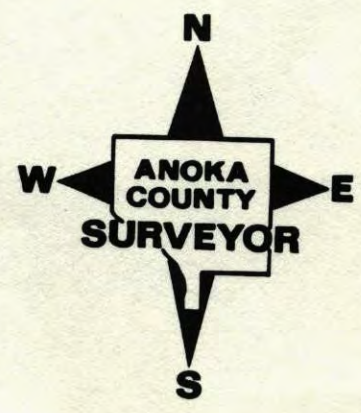



S  $\frac{1}{16}$  COR. ON N.S.  $\frac{1}{4}$  LINE SEC. 11-32-24  
found Sand Stone rock  
chiseled + in top.

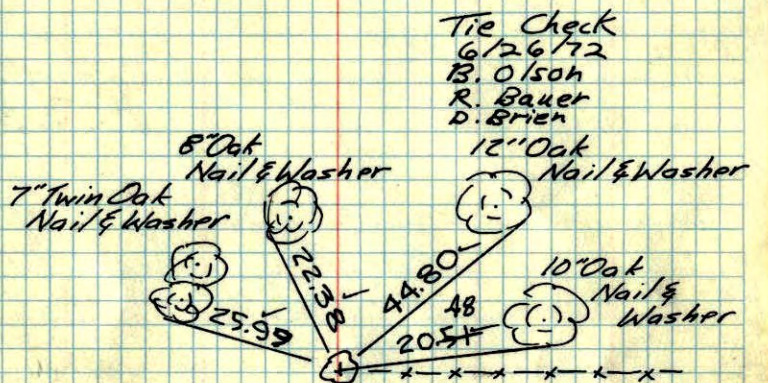

Oct. 16, 1961

R.O. Freeman  
M.D. Anderson

Tie Check  
July 12, 1968  
H. Larson  
R. Olson  
P. Pich

TIE CHECK  
5-26-76  
D. DANL  
B. SANNEBO  
& ADAMS

TIE CHECK  
6-17-82  
R. ROSS  
P. HORNBY  
J. BEIER


TEMPERATURE CORRECTED  
AND HORIZONTALLY  
TAPED MEASUREMENTS

ROLAND W. ANDERSON  
COUNTY SURVEYOR  
ANOKA COUNTY, MINNESOTA

Ties checked  
(Rock was out of ground  
-replaced in original position)  
Aug. 17, 1964  
M. D. Anderson  
J. Dunlop

16 Oct 1961  
Freeman Anderson  
+ 75°

S  $\frac{1}{16}$  Cor on N  $\frac{1}{4}$  S  $\frac{1}{4}$  Line Sec 11-32-24  
Grow Twn. Found Sand Stone Rock  
chiseled + in top.

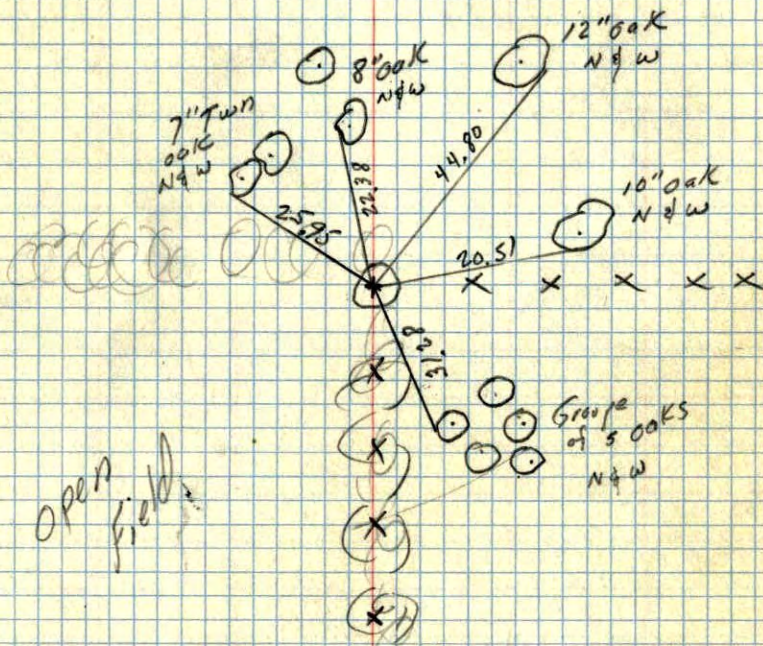

open field

TEMP.  
CORR.