

# CERTIFICATE OF LOCATION OF GOVERNMENT CORNER

County of Anoka


State of Minnesota

Witness Corner of Sec. 18 Township 32 Range 24  
 (Witness to the E1/4 Corner on the east line of the S.E. quarter.)

I hereby certify that on the 7th day of November, 2001, I found the described corner which was evidenced by GPS and area resurvey

and I further certify that to perpetuate the location of said corner, I did, at the exact location thereof, place a permanent marker consisting of a cast iron monument (FLUSH)

which reference or witness monuments are located in the manner following:

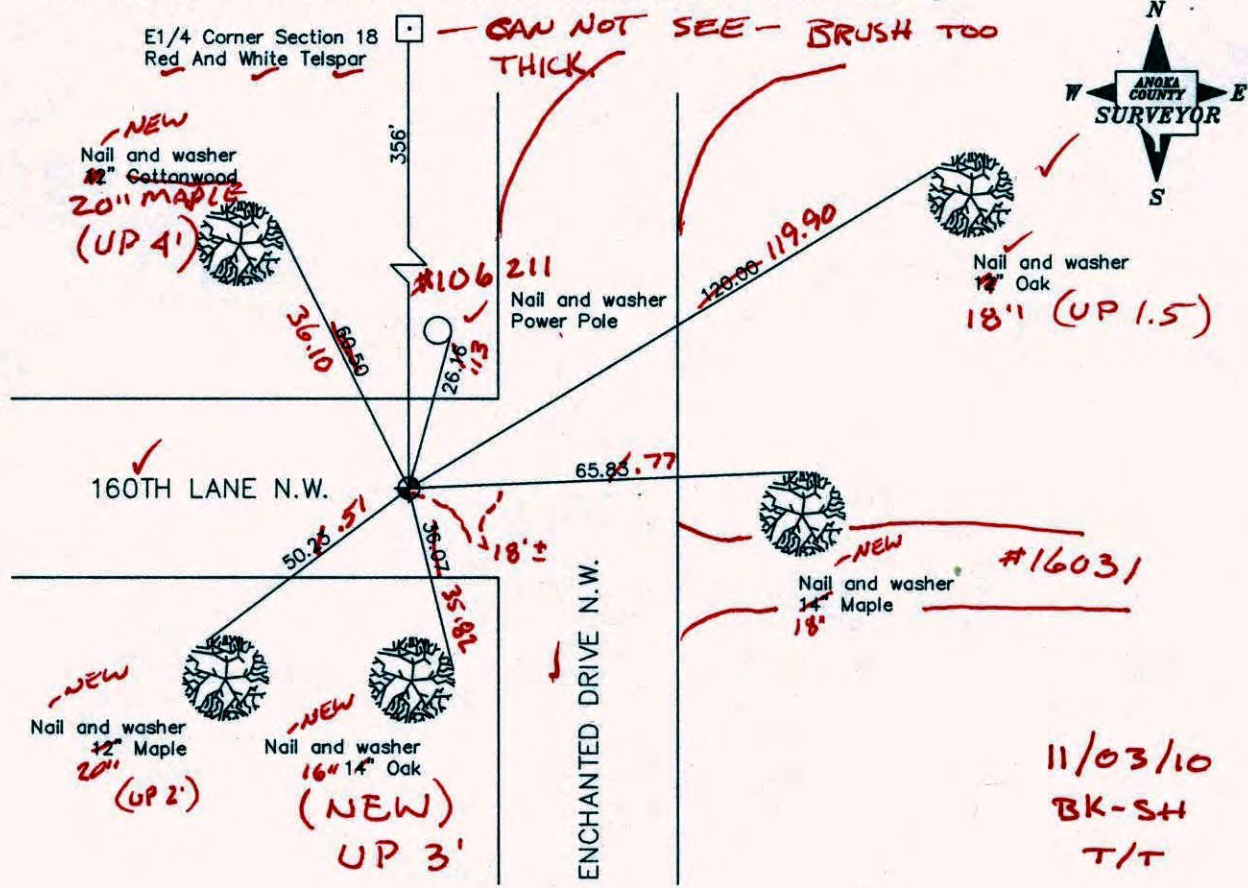

Revised date


N.A.D. 1983 Co-ordinates

County Project Co-ordinates Northing <u>182676.2673</u> Easting <u>474142.0058</u>	State Plane Co-ordinates Y _____ X _____
--	--

Date 11/7/01



WITNESS COR 356' S OF E 1/4 SEC 18

SET C.I.M. & GPS POSITION

NATIONAL PRINTFAST NO. 446

