


CERTIFICATE OF LOCATION OF GOVERNMENT CORNER
 County of Anoka State of Minnesota

Witness Corner of Sec. 19 Township 32 Range 24
 North Line

I hereby certify that on the 2nd day of July, 1963, I found the described corner which was evidenced by area resurvey

and I further certify that to perpetuate the location of said corner, I did, at the exact location thereof, place a permanent marker consisting of a cast iron monument located 1045' east of the Northwest corner of Section 19 (MON. IS BROKEN OFF - DOWN 0.7')

which reference or witness monuments are located in the manner following:

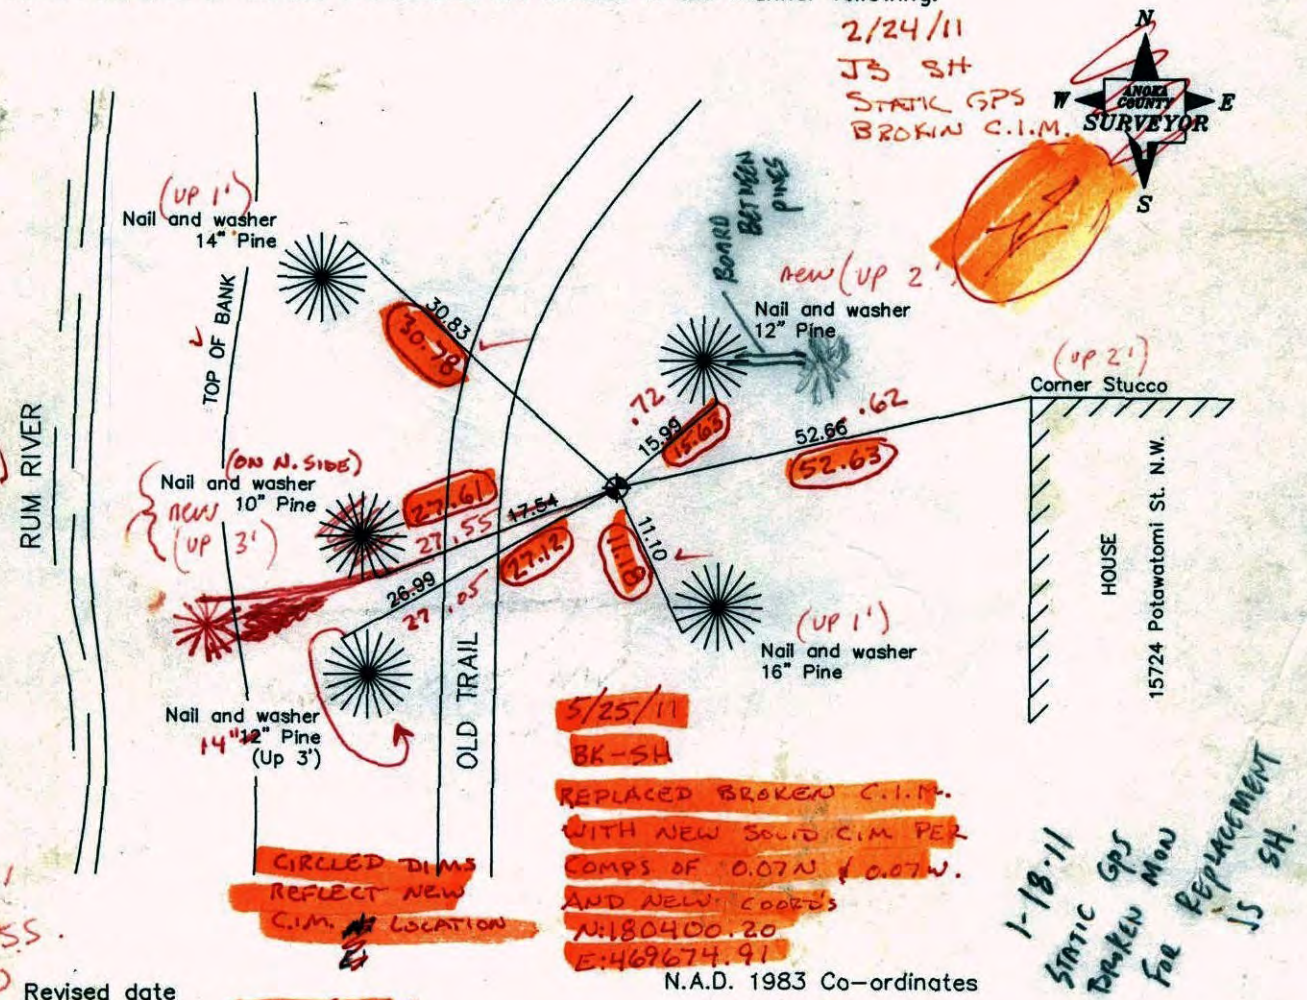

Revised date

8/8/88
7/27/93
2/12/01

VRS COORDS

COULD NOT GET 3D QUALITY TO GET BELOW 0.25. WOULD NOT ACCEPT SHOTS TO STORE. WAITED 50 MINUTES FOR BETTER QUALITY BUT DID NOT ACHIEVE IT.

County Project Co-ordinates
Northing 180400.2740
Easting 469674.8450

State Plane Co-ordinates
Y _____
X _____

Date 2/12/01

Point Id	Point Class	Date/Time	Northing	Easting	Ortho. Hgt.
<input checked="" type="checkbox"/> GOVERNMENT	Control	01/18/2011 09:49:40	159615.4529	469038.3163	977.2750
<input checked="" type="checkbox"/> highway	Control	01/18/2011 10:12:05	166323.7772	491096.2545	897.2833
<input checked="" type="checkbox"/> AND8	Averaged	01/18/2011 11:54:05	196028.4967	474045.1922	854.6362
<input checked="" type="checkbox"/> AND68	Averaged	01/18/2011 14:36:25	180400.1420	469675.0118	888.7022

N/A to we using
1794.044

AND68 VRS

2-24-11

15 SH

3D QUALITY

0-11

180400.1667

469674.9394


Point Id	Point Class	Date/Time	Northing	Easting	Ellip. Hgt.	Ortho. Hgt.	Geoid Sep.
<input checked="" type="checkbox"/> GOVERNMENT	Control	02/24/2011 09:12:40	159615.4529	469038.3163	-39.2796	977.2750	-1016.5546
<input checked="" type="checkbox"/> highway	Control	02/24/2011 09:36:55	166323.7776	491096.2544	-119.0334	897.2833	-1016.3166
<input checked="" type="checkbox"/> AND68	Averaged	02/24/2011 11:22:00	180400.1126	469674.9638	-128.4798	888.7879	-1017.2677
<input checked="" type="checkbox"/> RAM99	Averaged	02/24/2011 14:26:50	175093.6297	455468.5673	-154.0600	863.1993	-1017.2592

*N 1/4 Cor to WC using
1794.092*

WITNESS CORNER ON THE NORTH

LINE OF SEC 19 T32 R24
(1045' EAST OF NW COR)

RETIED CAST IRON MONUMENT.

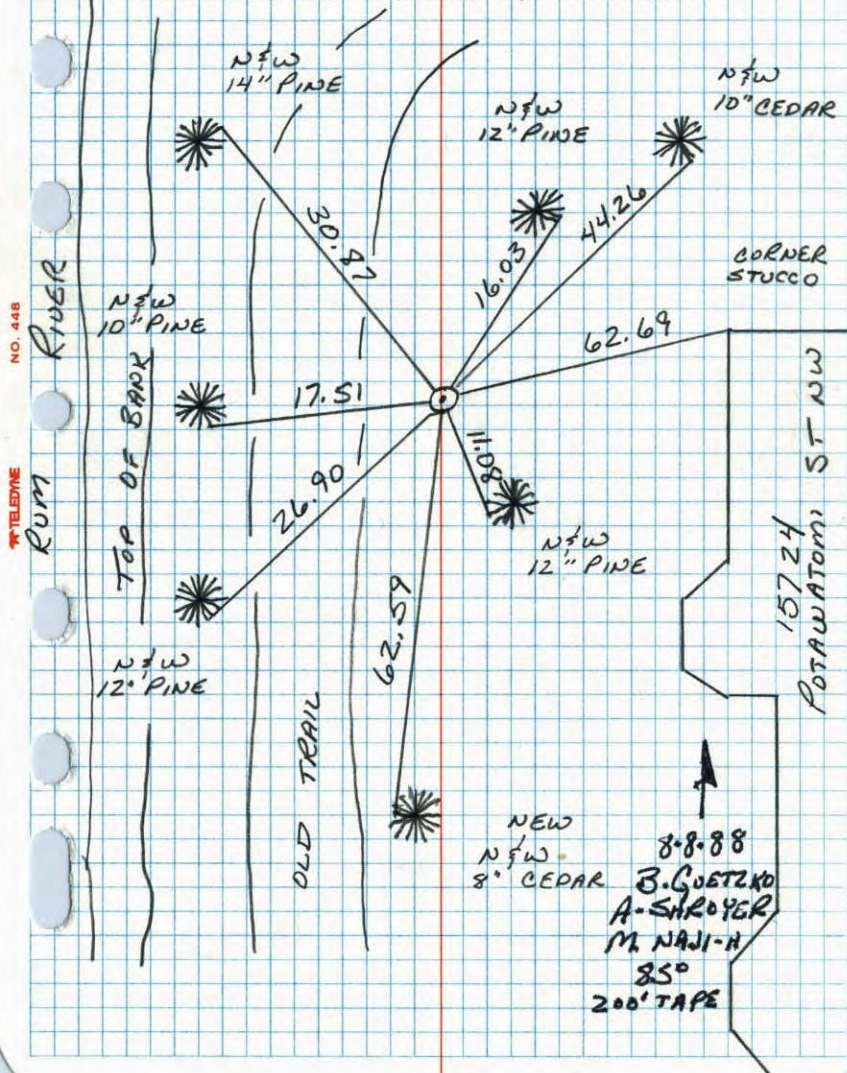

Witness Cor. N. line Sec. 19 T32, R 24

(1045' E. of NW cor)

Set Cast Iron Monument from resurvey


ALL TIES IN BUT UNTAINABLE, PUT IN NEW TIES

6-2-76

G. ADAMS

B. SANNERUD

G. DAHL

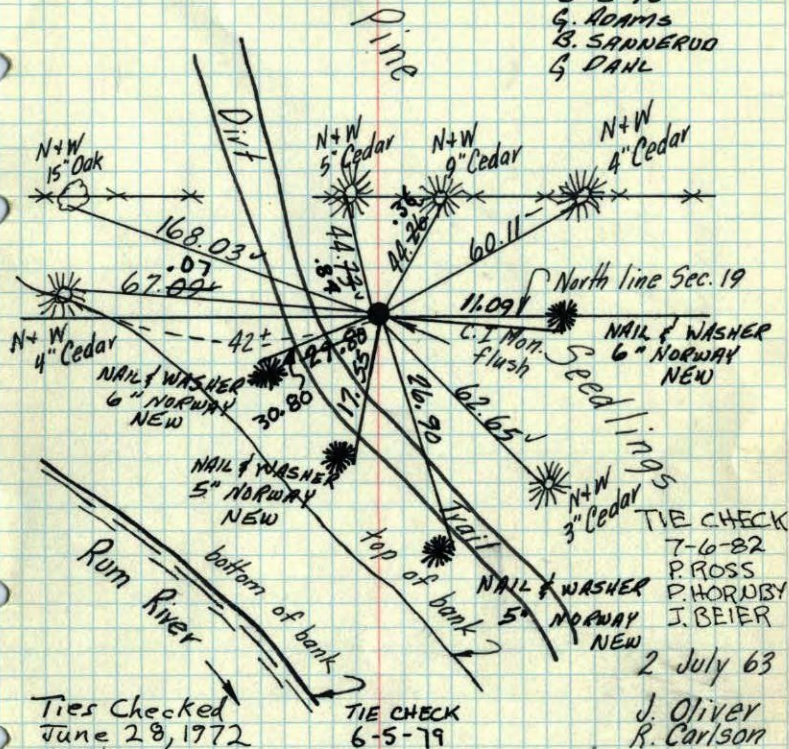Ties Checked
June 28, 1972
B. Olson
R. Bauer
D. BrienTIE CHECK
6-5-79
B. STEPHENS
D. STEPHENS
D. KAGLAKTEMPERATURE CORRECTED
AND HORIZONTALLY
TAPED MEASUREMENTSTie Check
July 10, 1968
H. Larson
R. Olson
P. PiehROLAND W. ANDERSON
COUNTY SURVEYOR
ANOKA COUNTY, MINNESOTA

Witness Cor. on No. line Sec. 19,
T32, R24 (1045' E. of NW Cor.)

Set Cast Iron Monument from
Resurvey.

