

CERTIFICATE OF LOCATION OF GOVERNMENT CORNER

County of Anoka


State of Minnesota

East $\frac{1}{4}$ Corner of Sec. 29 Township 32 Range 24

I hereby certify that on the 15th day of July, 1970, I found the described corner which was evidenced by area resurvey

and I further certify that to perpetuate the location of said corner, I did, at the exact location thereof, place a permanent marker consisting of a cast iron monument down 2'± with sign and post by 1/2" iron pipes (MONUMENT 0.25 mi± SOUTH OF NORTH EDGE OF FIELD.)

which reference or witness monuments are located in the manner following:

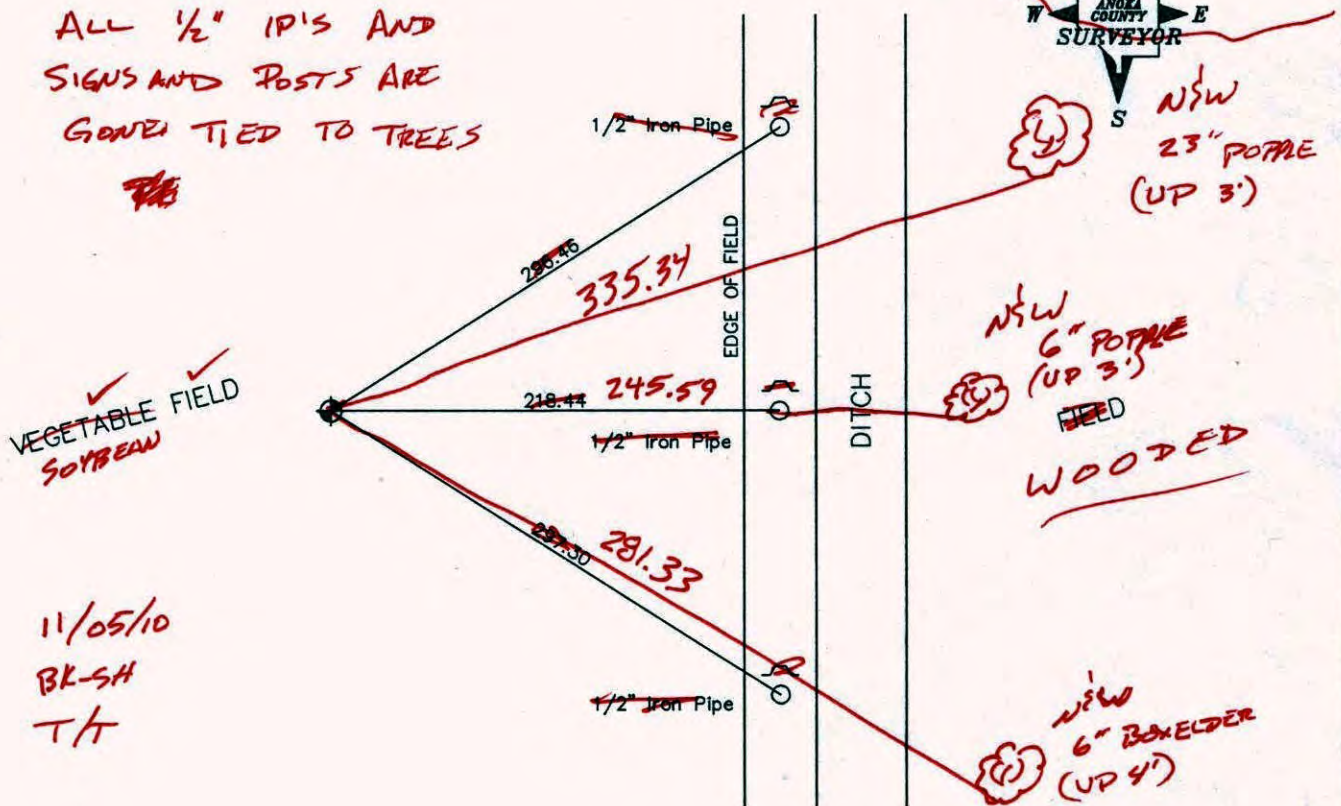

Revised date

6/6/85
9/9/88
7/27/93

N.A.D. 1983 Co-ordinates

County Project Co-ordinates	State Plane Co-ordinates
Northing 172436.5658	Y _____
Easting 479292.0765	X _____

Date _____

CERTIFICATE OF LOCATION OF GOVERNMENT CORNER

County of Anoka


State of Minnesota

EAST ONE QUARTER Corner of Sec. 29 Township 32 Range 24


I hereby certify that on the 15 day of JULY, 1970, I found the described corner which was evidenced by AREA RESURVEY REPLACED AND RETIED 9-9-88

and I further certify that to perpetuate the location of said corner, I did, at the exact location thereof, place a permanent marker consisting of CAST IRON MONUMENT
DOWN 2'± SIGN AND POSTS BY 1/2" IRON PIPES

which, reference, or witness monuments are located in the manner following:

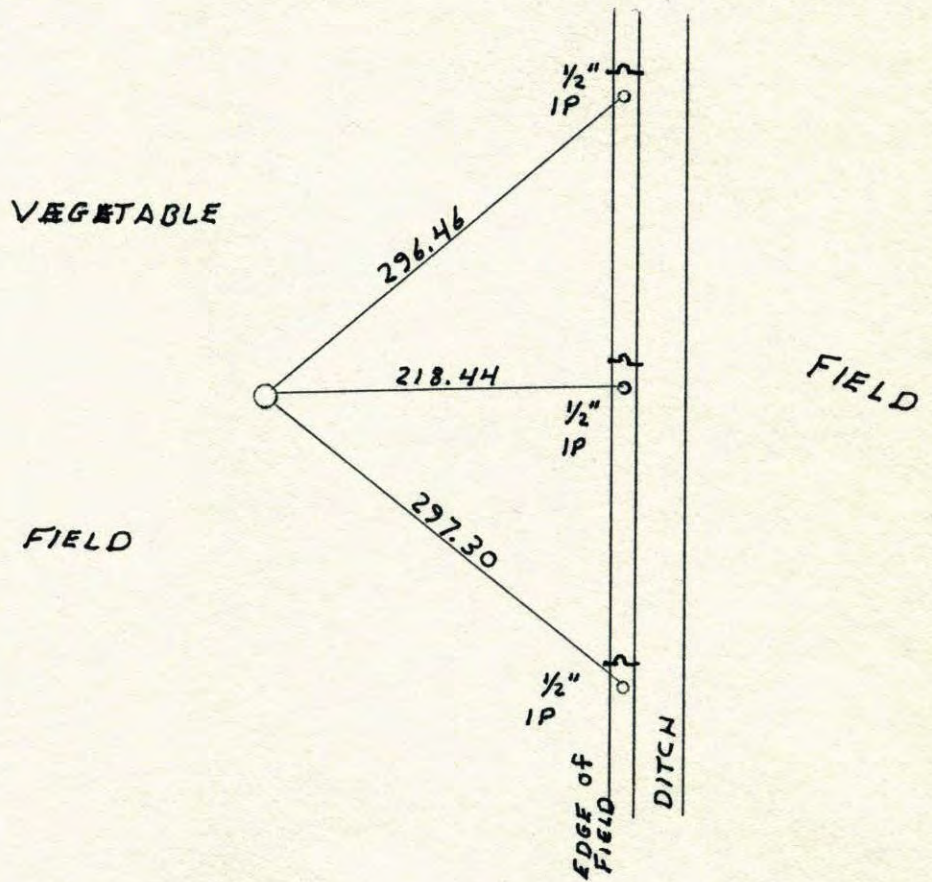


Revised date	Revised date	Revised date
6-29-82		
6-6-85		
9-9-88 <small>UL</small>		
7-27-93		

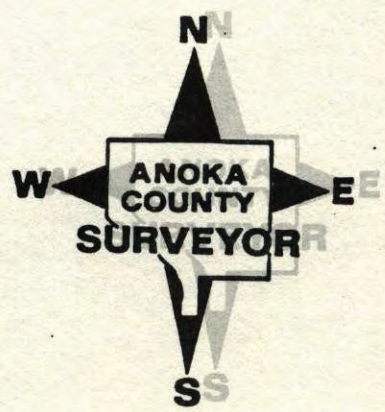

E
W 1/4 CORNER SECTION 28 T32 R24

RESET CAST IRON MONUMENT FROM AREA
RESURVEY SIGN + POSTS BY I.P.S.

9-9-88
W. LARSON
B. GRETZKO
J. STEVENSON

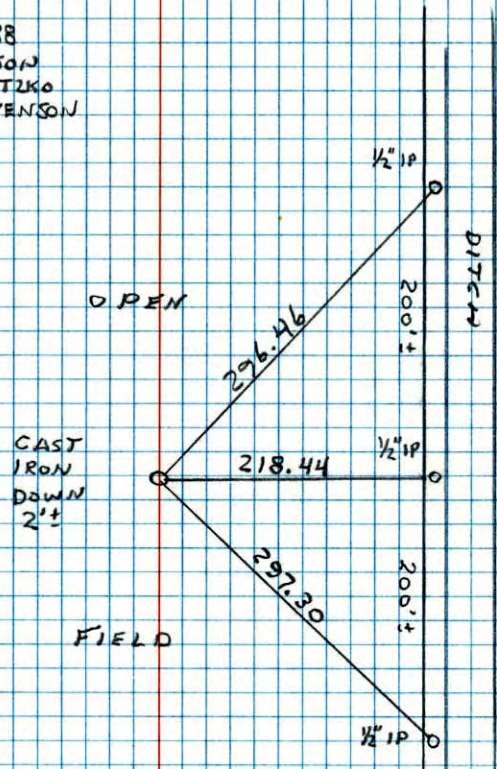


NO. 448
TELETYPE

E 1/4 Cor. Sec. 29-T32-R24

Set 1/4 Corner (spike) 1/2 way and on line on
North-South Section Line. Set Iron Pipe
ties along ditch.

July 15, 1970
M.D. Anderson
H.J. Larson
W. Weslander

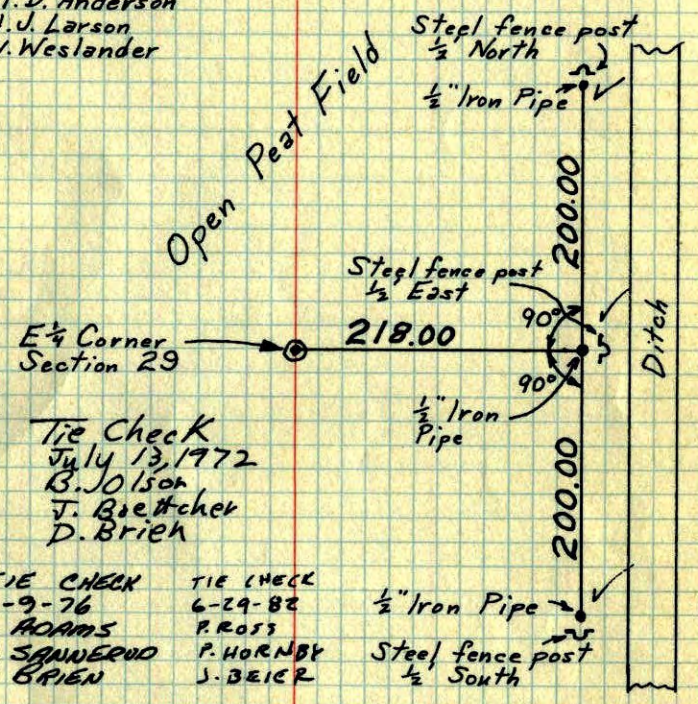

Tie Check
July 13, 1972

TIE CHECK 6-9-76 G. ADAMS B. SANDERUD S. BRIEN	TIE CHECK 6-29-82 P. ROSS P. HORNBY J. BEIER
--	--

TIE CHECK
6-11-79
D. STEPHENS
D. STEPHENS
P. ROSS


TEMPERATURE CORRECTED
AND HORIZONTALLY
TAPED MEASUREMENTS

ROLAND W. ANDERSON
COUNTY SURVEYOR
ANOKA COUNTY, MINNESOTA

E 1/4 Cor. Sec. 29-T32-R24

set 1/4 Cor. 1/2 way & on line
on N & S. Sec. line

Set iron pipe ties
along ditch

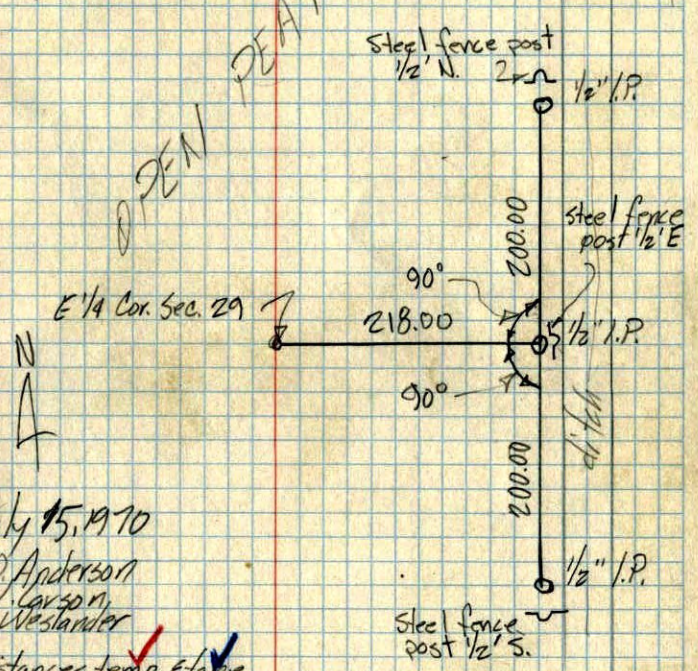

July 15, 1970

M.D. Anderson
H.V. Larson
W. Westlander

distances temp. & slope
corrected in field