


Center Sec. 17 T32 R24

Found and tied by LeRoy Winner.

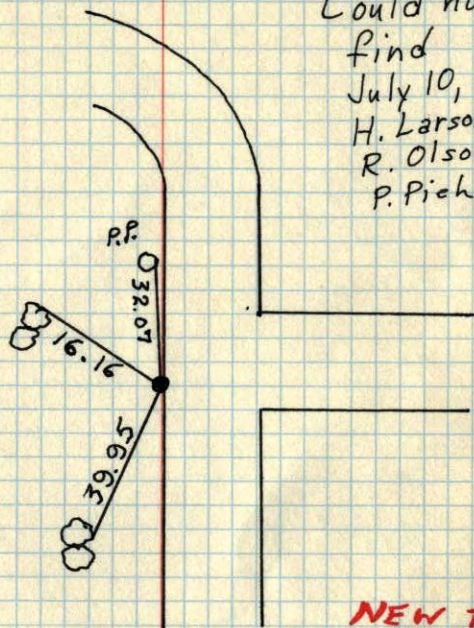


Could not
find
July 10, 1968
H. Larson
R. Olson
P. Pich

NEW TIE
BOOK

LeRoy Winner
6/16/66

Center Sec. 17 T32 R24


Found and tied by LeRoy Winner.

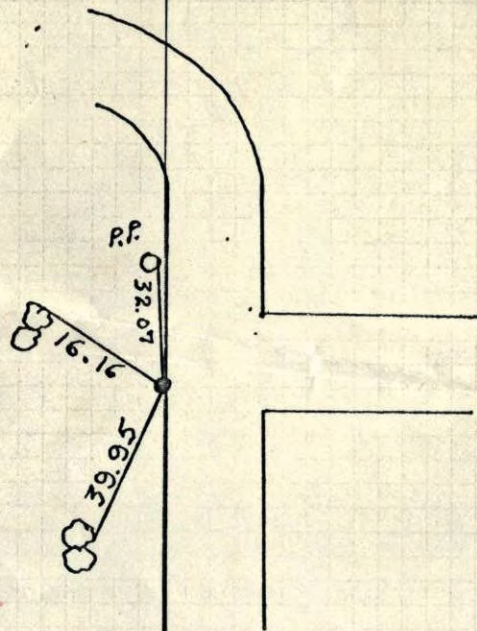

Could not
find
July 10, 1968
H. Larson
R. Olson
P. Pich

LeRoy Winner
6/16/66

Center sec. 17-32-24

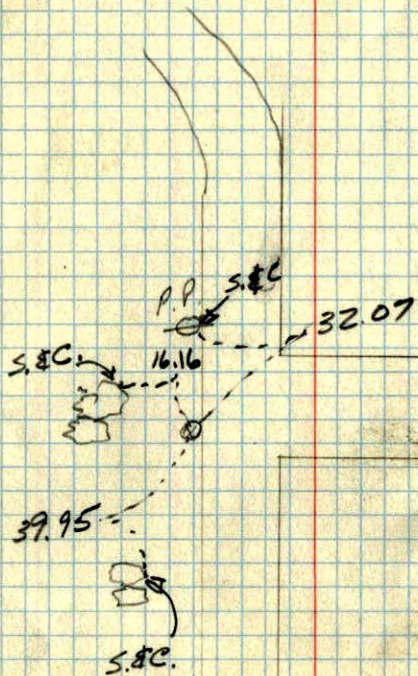

Le Roy Winner
6/16/66