


96 ✓


Center Corner of Section 27 T.32 R.24

Could not find
July 16, 1968
H. Larson
G. Elsberry

To Constance

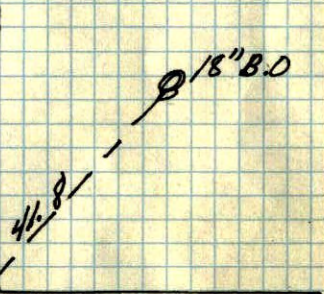

To Andrew

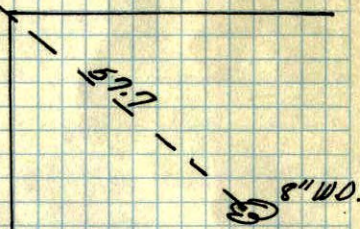

Could not Find
6/30/72
9 Jan 76
G. ROAMS

COULD NOT FIND
6-25-82
P. ROSS
P. HORNBY
M. LICK

Anoka Co. Hwy Dept.