


Lundstrom

(2)

SE. corner Sec. 31-T. 32 R. 29
concr. mon. broken below
ground - upper 1/2 can be
lifted out.

Wooden 1x2s almost flush
with ground

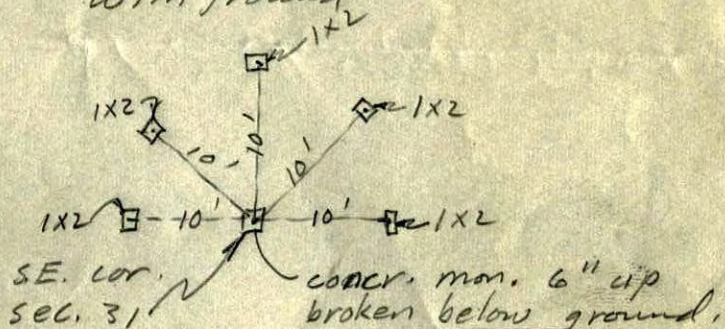

Leaving fence corner
about 2.5' to north