


SE COR Sec 33-T32-R24

Iron Up .6'  
Steel Fence Post  
beside it.

SET CAST IRON MON. FLUSH 6-7-77  
H. LARSON  
B. GUETZKO  
J. BOETTCHER

Ties Checked  
July 13, 1972  
B. Olson  
J. Boettcher  
D. Brien

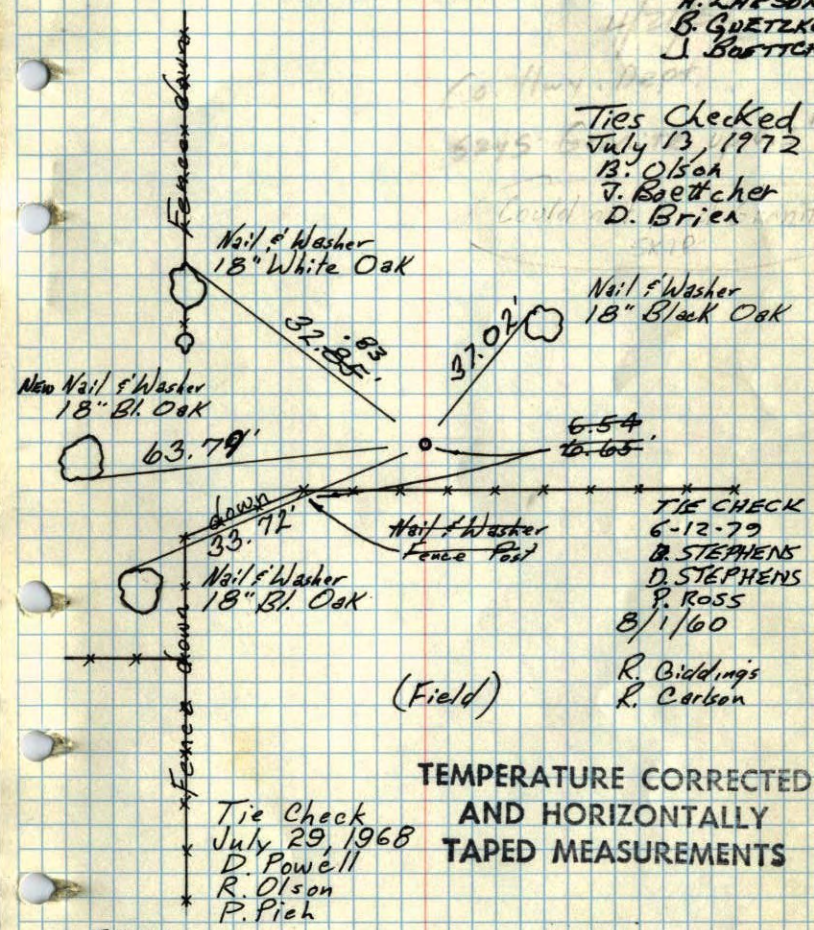

TIE CHECK  
6-12-79  
B. STEPHENS  
D. STEPHENS  
P. ROSS  
8/1/60  
R. Biddings  
R. Carlson

TEMPERATURE CORRECTED  
AND HORIZONTALLY  
TAPED MEASUREMENTS

Tie Check  
July 29, 1968  
D. Powell  
R. Olson  
P. Pich

TIE CHECK  
6-16-76  
G. ADAMS  
B. GUETZKO  
B. SAN DERVO

ROLAND W. ANDERSON  
COUNTY SURVEYOR  
ANOKA COUNTY, MINNESOTA