


Witness Cor. on West line Sec. 19 T 32, R 24

Set Cast Iron Monument from resurvey

Ties Checked
July 13, 1972
B. Olson
J. Boettcher
D. Brien

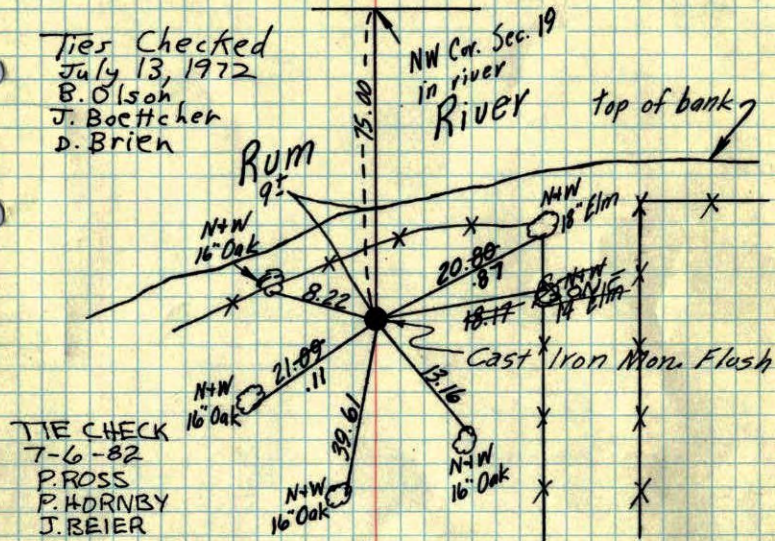

TIE CHECK
7-6-82
P. ROSS
P. HORNBY
J. REIER

Tie Check
July 16, 1968
H. Larson
G. Elsberry

TIE CHECK
6-2-76
G. ADAMS
D. DANL
B. SANNEROD

TEMPERATURE CORRECTED
AND HORIZONTALLY
TAPED MEASUREMENTS

TIE CHECK
6-21-79
B. STEPHENS
D. STEPHENS
P. ROSS
80" TAPE #4

ROLAND W. ANDERSON
COUNTY SURVEYOR
ANOKA COUNTY, MINNESOTA

Line of
16" (Average) Oaks


20 Sept. 63
J. Oliver
M. Anderson

Tie check
Aug 26, 1964
M. D. Anderson
J. Dunlap

All ties good

Witness Corner on West line Sec. 19, T32, R24 Set Cast Iron Monument from Resurvey

N 20 Sept 63
66P #2
J. Oliver
M. D. Anderson
R. Carlson

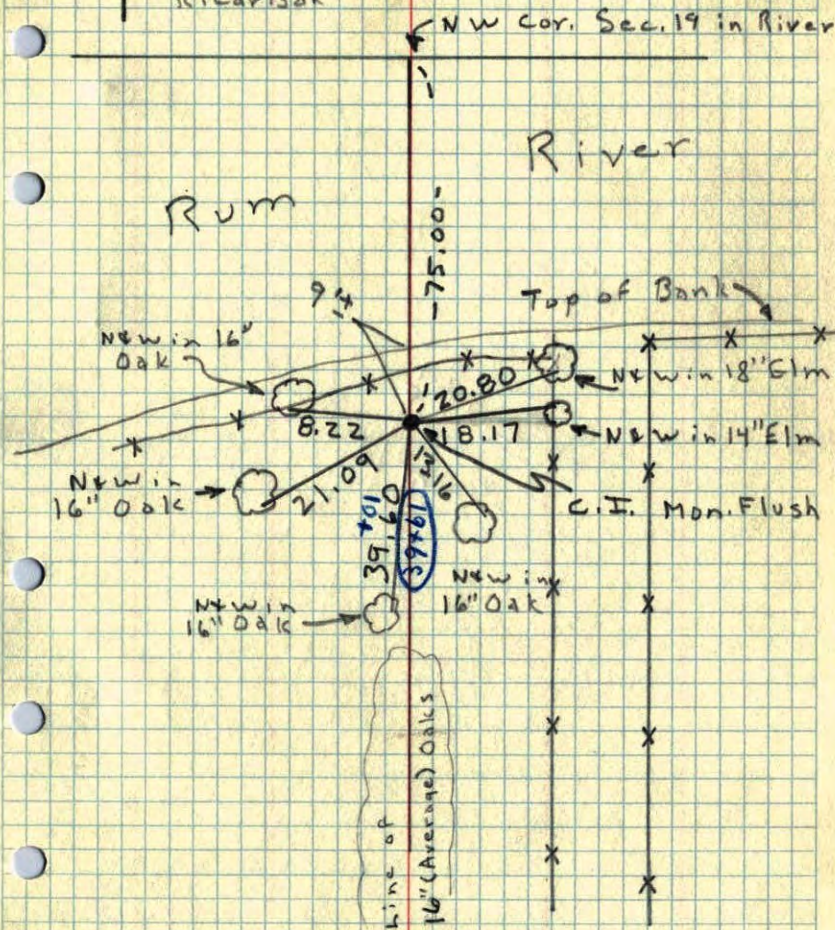

Line of
16" (Average) Oaks