

# CERTIFICATE OF LOCATION OF GOVERNMENT CORNER

County of Anoka


State of Minnesota

CENTER \_\_\_\_\_ Corner of Sec. 4 Township 31 Range 23

I hereby certify that on the \_\_\_\_\_ day of \_\_\_\_\_, 1962, I found the described corner which was evidenced by 2" IRON SET BY CARLEY

and I further certify that to perpetuate the location of said corner, I did, at the exact location thereof, place a permanent marker consisting of TWO INCH IRON PIPE

which reference or witness monuments are located in the manner following:

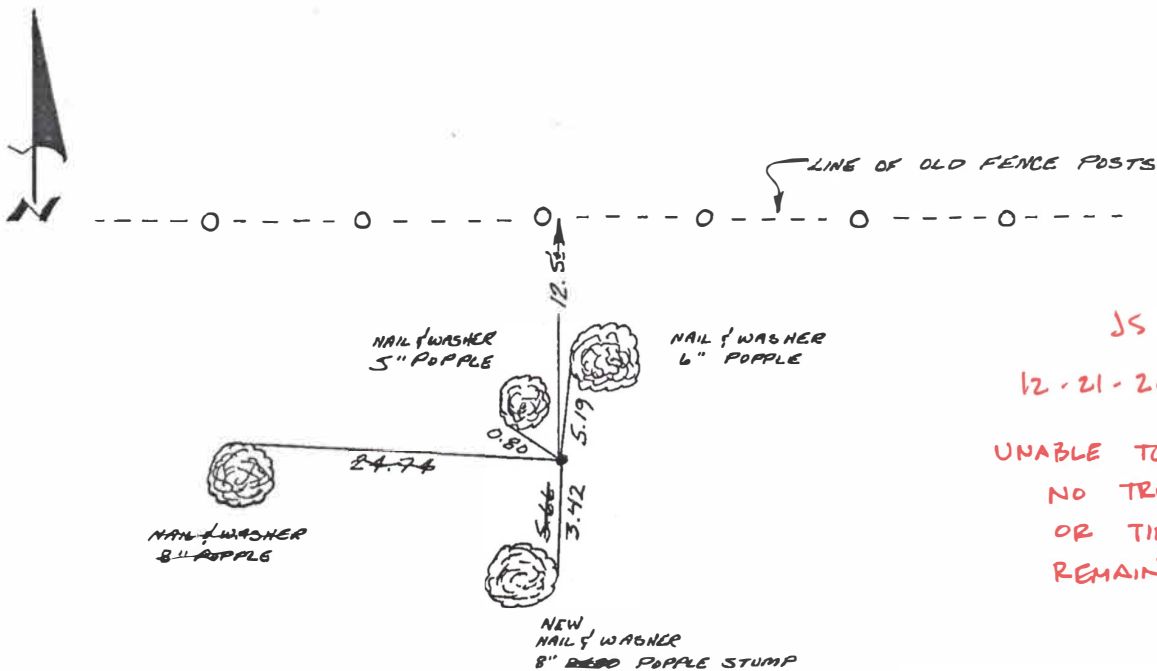

JS AV  
 12-21-2020  
 UNABLE TO FIND  
 NO TREES  
 OR TIES  
 REMAIN  
 SEARCH GOORD'S ?

Revised date	By
1962	CARLEY
7-15-68	DP RP RD
5-14-75	DD JB BS
9-2-77	SB JS
7-22-83	PR JB
6-5-86	D. ROSS

Minnesota State Plane Coordinates

South Zone

Y \_\_\_\_\_ X \_\_\_\_\_

County Surveyor \_\_\_\_\_

Date \_\_\_\_\_

Registered Land Surveyor No. \_\_\_\_\_

