

# CERTIFICATE OF LOCATION OF GOVERNMENT CORNER

County of Anoka


State of Minnesota

CENTER \_\_\_\_\_ Corner of Sec. 4 Township 31 Range 23

I hereby certify that on the \_\_\_\_\_ day of \_\_\_\_\_, 1962, I found the described corner which was evidenced by 2" IRON SET BY CARLEY

and I further certify that to perpetuate the location of said corner, I did, at the exact location thereof, place a permanent marker consisting of TWO INCH IRON PIPE

which reference or witness monuments are located in the manner following:

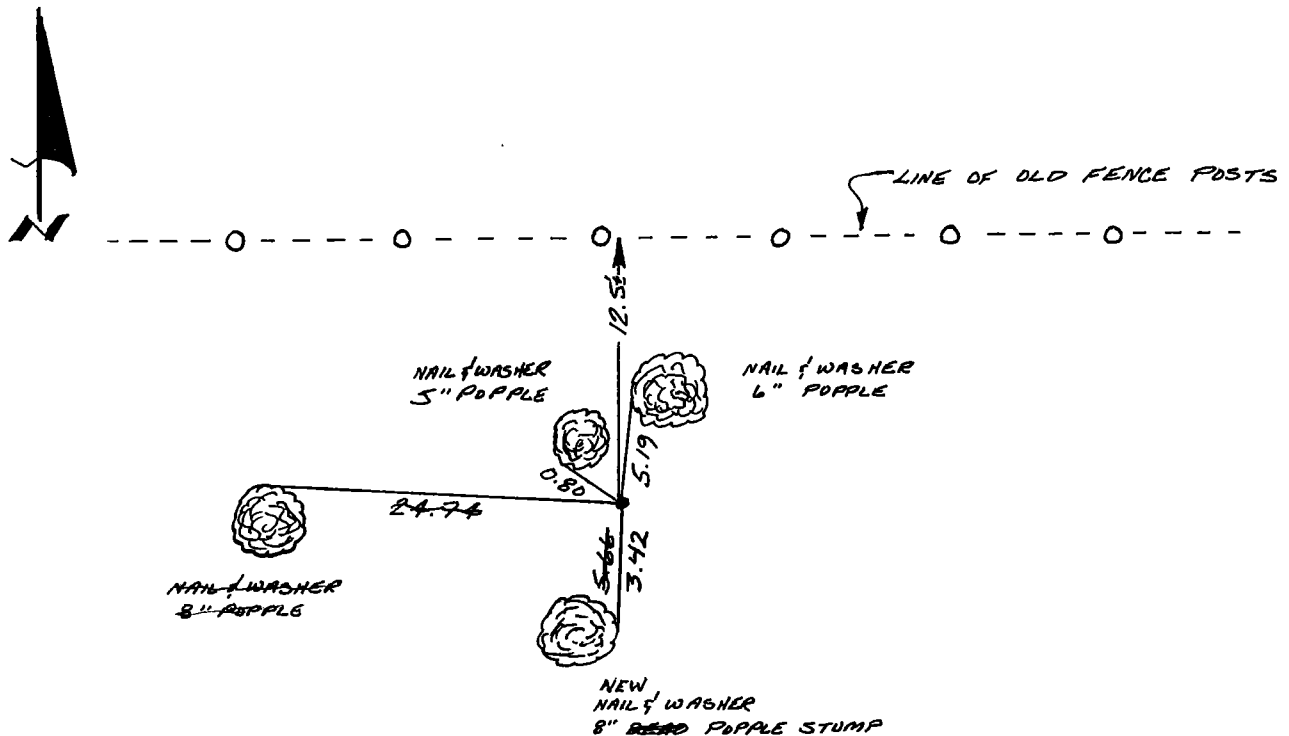

Revised date
1962
7-15-68
5-14-75
9-2-77
7-22-83
6-5-86

By
CARLY
DP RP RO
DD JB BS
SB SS
PR JB
D. ROSS

Minnesota State Plane Coordinates  
South Zone

Y \_\_\_\_\_ X \_\_\_\_\_

County Surveyor \_\_\_\_\_ Date \_\_\_\_\_

Registered Land Surveyor No. \_\_\_\_\_