

# CERTIFICATE OF LOCATION OF GOVERNMENT CORNER

County of Anoka

State of Minnesota


## North 1/4 Corner of Sec. 9 Township 31 Range 23

On the 9th day of November, 1973, the described corner was evidenced by area resurvey

and to perpetuate the location of said corner, at the exact location thereof, a permanent marker was placed consisting of a cast iron monument

AND on the 18th day of May, 2022, said permanent marker was found flush and the ties were updated

Updated reference ties are as shown below.

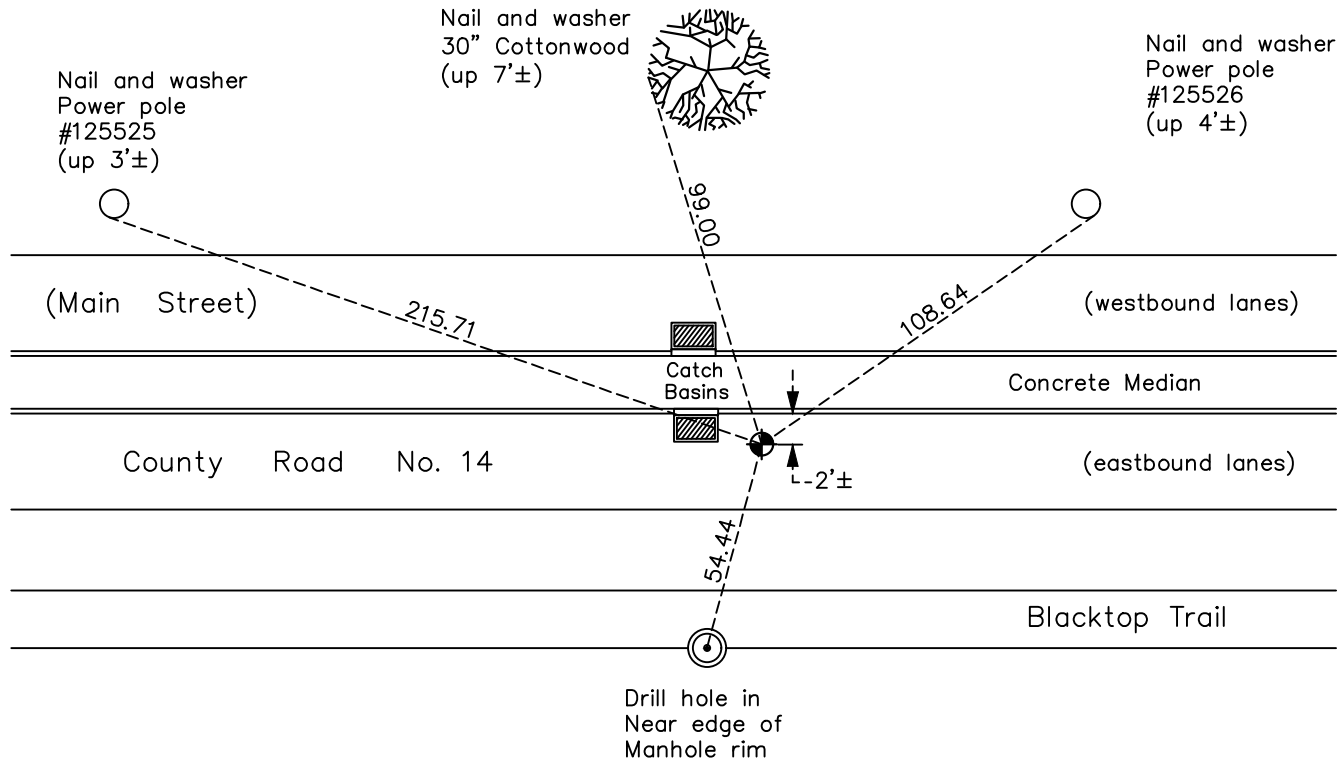

Revision Date  
07/13/2022

N.A.D. 1983 Coordinates  
 (1996 Adjustment)

County Project Coordinates	
Northing	<u>159038.6176</u>
Easting	<u>513535.2675</u>
Date	<u>9/03/98</u>

I hereby certify that this United States public land survey monument record is correct and complete to the best of my knowledge and belief.

David Zieglmeier Date 2/8/23

David Zieglmeier Anoka County Surveyor  
 Minnesota License Number 46179

# HISTORY OF GOVERNMENT CORNER

Page No. 27

County of Anoka

State of Minnesota

## North 1/4 Corner of Sec. 9 Township 31 Range 23

### **CORNER HISTORY:**

January 1961 - Found railroad spike on line, halfway between Northwest and Northeast corners of section 9. Established ties to spike.

May 3, 1963 - Found railroad spike and updated ties.

July 6, 1964 - Found railroad spike and updated ties.

July 17, 1968 - Found railroad spike and replaced with a cast iron monument flush. Updated ties.

August 24, 1971 - Found cast iron monument and updated ties.

November 9, 1973 - Found cast iron monument and updated ties.

May 22, 1975 - Found cast iron monument and updated ties.

August 10, 1977 - Found cast iron monument and updated ties.

June 5, 1980 - Found cast iron monument and updated ties.

June 10, 1986 - Found cast iron monument and updated ties.

September 1, 1992 - Found cast iron monument and updated ties prior to road construction.

July 12, 1993 - Set cast iron monument flush after road construction and updated ties.

July 28, 1995 - Found cast iron monument and updated ties.

September, 3 - 1998 - Found cast iron monument, established NAD 1983 (1996 adj.) Anoka County project coordinates by static GPS methods and updated ties.

August 17, 2006 - Found cast iron monument and updated ties.

July 13, 2010 - Found cast iron monument down after road overlay. Raised cast iron monument flush and updated ties.

July 30, 2014 - Found cast iron monument and updated ties.

March 23, 2016 - Found cast iron monument, verified position by VRS GPS methods, set construction ties and updated corner ties prior to road construction. Removed monument.

November 14, 2016 - Set cast iron monument flush after road construction using static GPS methods and updated ties.

June 18, 2019 - Found cast iron monument, verified position by VRS GPS methods and updated ties.

May 18, 2022 - Found cast iron monument flush, verified position by VRS GPS methods and updated ties.