

CERTIFICATE OF LOCATION OF GOVERNMENT CORNER

County of Anoka

State of Minnesota


Northwest Corner of Sec. 9 Township 31 Range 23

On the 3rd day of May, 1963, the described corner was evidenced by an iron pipe

and to perpetuate the location of said corner, at the exact location thereof, a permanent marker was placed consisting of a cast iron monument

AND on the 18th day of May, 2022, said permanent marker was found flush and the ties were updated

Updated reference ties are as shown below.

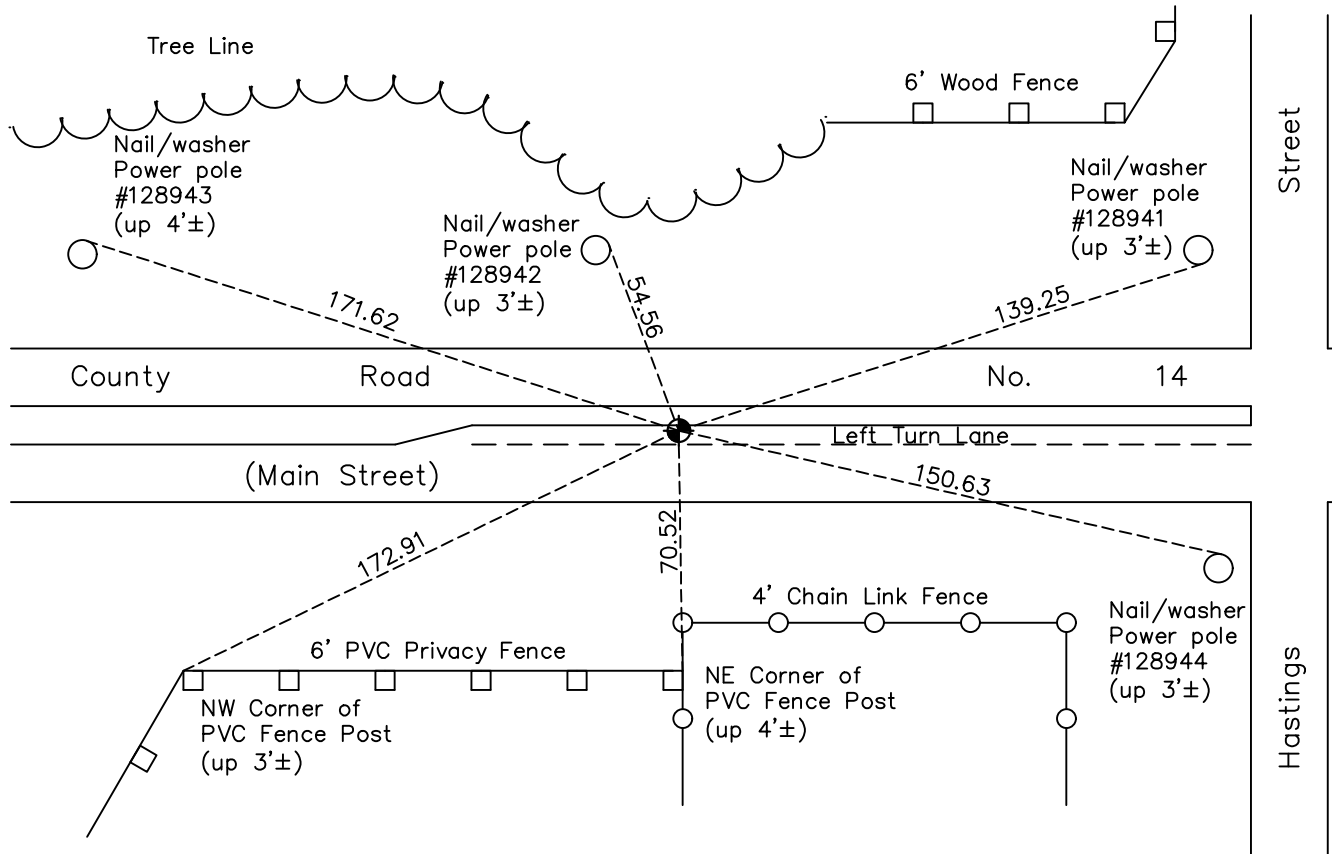

Revision Date
 07/13/2022

N.A.D. 1983 Coordinates
 (1996 Adjustment)

County Project Coordinates	
Northing	159054.2234
Easting	510865.1972
Date	9/03/98

I hereby certify that this United States public land survey monument record is correct and complete to the best of my knowledge and belief.
David Zieglmeier Date 2/8/23
 David Zieglmeier Anoka County Surveyor
 Minnesota License Number 46179

HISTORY OF GOVERNMENT CORNER

Page No. 28

County of Anoka

State of Minnesota

Northwest Corner of Sec. 9 Township 31 Range 23

CORNER HISTORY:

May 3, 1963 - Found iron pipe flush in blacktop road and established ties to iron pipe.

July 6, 1964 - Found iron pipe and updated ties.

July 16, 1968 - Found iron pipe and updated ties.

July 17, 1968 - Found iron pipe and replaced with a cast iron monument flush.

August 24, 1971 - Found cast iron monument and updated ties.

May 22, 1975 - Found cast iron monument and updated ties.

August 10, 1977 - Found cast iron monument and updated ties.

June 5, 1980 - Found cast iron monument and updated ties.

August 21, 1984 - Found cast iron monument and updated ties.

August 23, 1984 - Found cast iron monument and updated ties prior to road construction.

June 4, 1986 - Found cast iron monument and updated ties.

August 3, 1990 - Found cast iron monument and updated ties.

July 28, 1995 - Found cast iron monument and updated ties.

September 3, 1998 - Found cast iron monument and updated ties. Established NAD 1983 (1996 adj.) Anoka County project coordinates by static GPS methods.

May 2, 2006 - Found cast iron monument and updated ties.

August 2, 2006 - Found cast iron monument and updated ties.

June 5, 2014 - Found cast iron monument and updated ties.

June 18, 2019 - Found cast iron monument. Verified position by VRS GPS methods. Updated ties.

September 9, 2020 - Reset cast iron monument flush after road construction using static GPS methods. Verified position by VRS GPS methods. Updated ties.

May 18, 2022 - Found cast iron monument flush. Verified position by VRS GPS methods. Updated ties.